


Dunnville Downtown Street Tree Planting

Lock Street East, Chestnut Street, Queen Street, and Bridge Street, Dunnville ON


February 2024

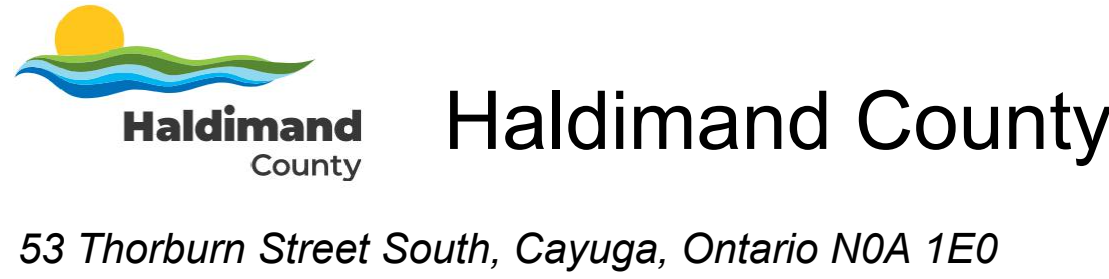


ska
 Stempski Kelly Associates Inc.
 Design Landscape Architecture Planning
 P.O. Box 399, Fergus, ON. N1M 3E2
 Voice (519) 787 4313
 sean@ska-design.ca www.ska-design.ca

Schedule of Drawings

L0	Lock St E - Streetscape Improvement Plan
L1	Chestnut St - Streetscape Improvement Plan
L2 & L3 & L4	Queen St - Streetscape Improvement Plan
L5	Bridge St - Streetscape Improvement Plan
L6	Details

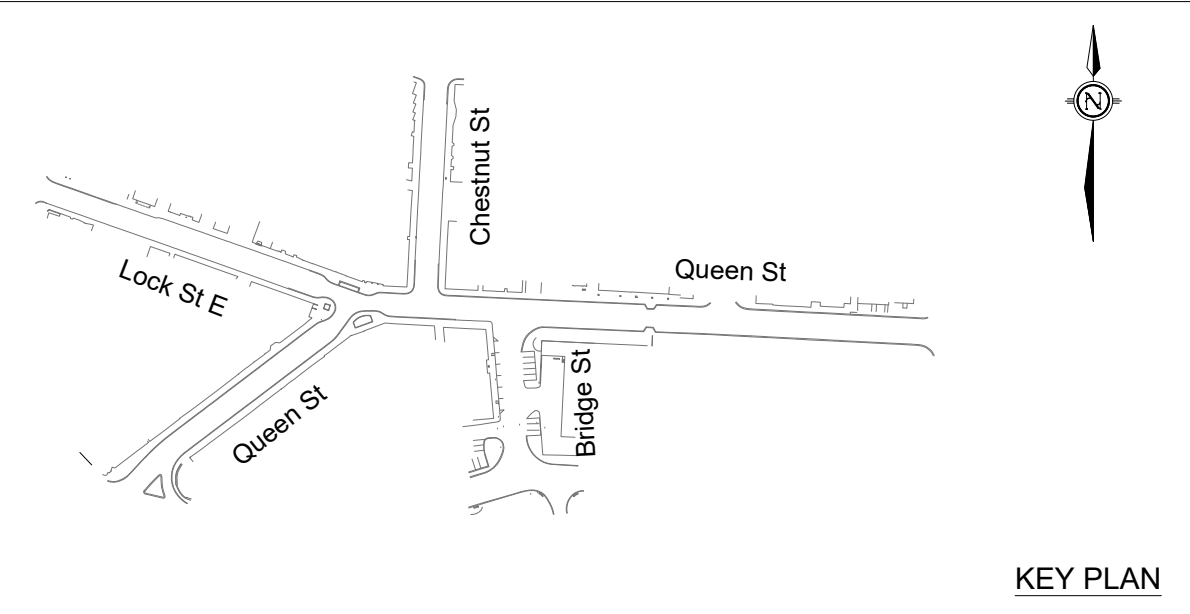

Cedar St

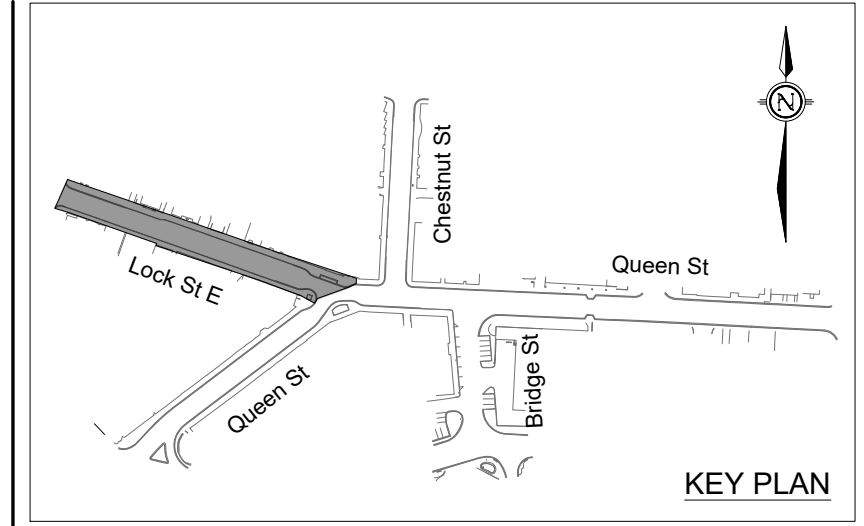

- Legend**
- Ex. Parking Signs to Remain Unless Otherwise Stated
 - Ex. Street Light Standard to Remain Unless Otherwise Stated
 - Ex. Outdoor Trash Can Unless Otherwise Stated
 - Ex. Street Signs to Remain Unless Otherwise Stated
 - Ex. Curb Cut to Remain Unless Otherwise Stated
 - Ex. Tree in Turf to Remain
 - Ex. Tree and Pit to be Removed
 - Ex. Tree to be Replaced with Upgraded Pit
 - Ex. Tree Pit to be Removed
 - New Tree and Pit
- Concrete-related Activities**
- A New Tree Pit Location (existing concrete to be removed), refer to Detail 1, Sheet L6
 - B Existing Tree Pit Location (new concrete to be placed to reconfigure tree pit opening size and/or to accept specified tree pit grate/guard), refer to Detail 2, Sheet L6
 - C Removal of Existing Tree Pit (new concrete placed, capping former; to be flush with adjacent ex. sidewalk), refer to Detail 3, Sheet L6

- Notes**
- The contractor shall check and verify all dimensions and conditions on the project and immediately report any discrepancies to the Landscape Architect before proceeding with work.
 - All dimensions are in millimeters unless otherwise stated.
 - The contractor shall layout the site and seek approval of the Landscape Architect prior to proceeding with work.
 - Project Boundary - Queen Street, Bridge Street, Lock Street East and Chestnut Street. Existing sidewalk and concrete curbs to remain undisturbed unless otherwise noted.

No.	Date	Item
4	29 Feb. 2024	Revised - As Constructed Drawings
3	8 Mar. 2022	Revised - for County Review
2	10 Jan. 2022	For County Review
1	13 Dec. 2021	Review

This drawing is an instrument of professional services and is intended for the use only in connection with the project covered by the consultant agreement.

Haldimand County
 53 Thorburn Street South, Cayuga, Ontario N0A 1E0


ska
 Stempski Kelly Associates Inc.
 Design Landscape Architecture Planning
 P.O. Box 399, Fergus, ON, N1M 3E2
 Voice (519) 787 4313
 sean@ska-design.ca www.ska-design.ca

Project Title
Dunnville Downtown Street Tree Planting
 Queen Street, Bridge Street, Lock Street East and Chestnut Street, Dunnville ON

JY/TV
 Drawn
 SK
 Checked
 #
 Project No.
 February 2024
 Date

Sheet Title
Lock St E - Streetscape Improvement Plan
 Scale
 1:150



Sheet No.
L0

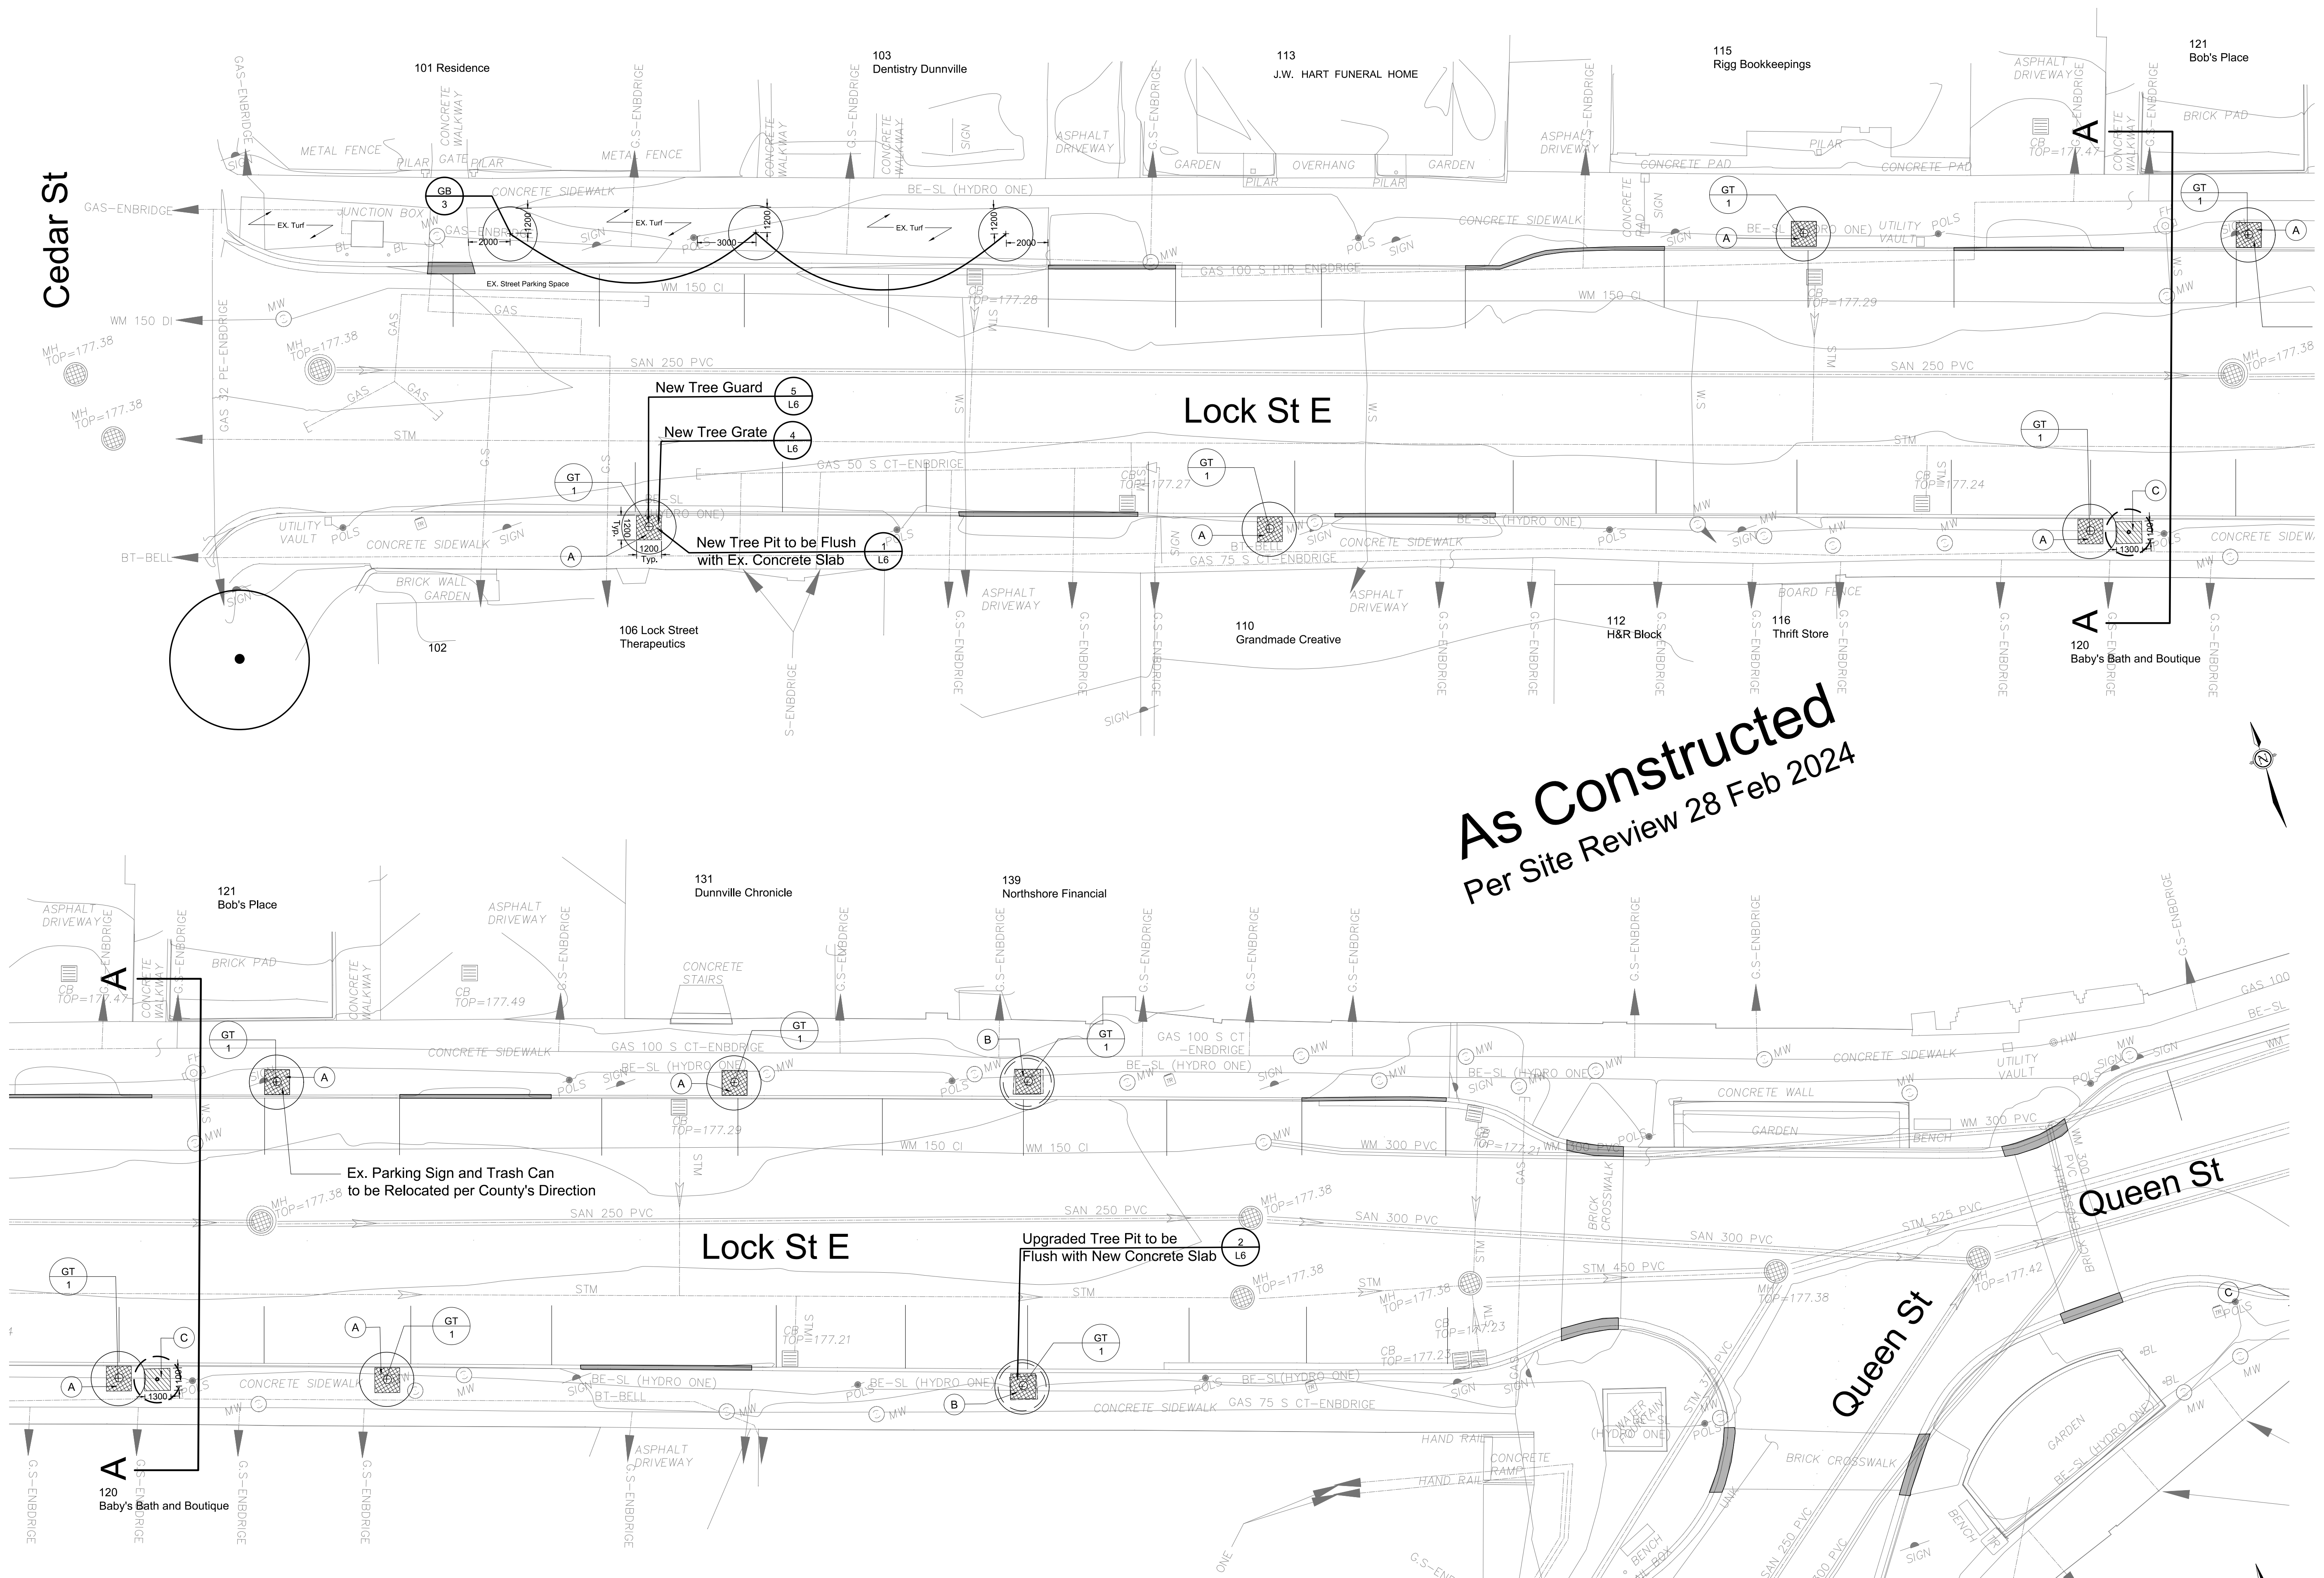

As Constructed
 Per Site Review 28 Feb 2024

PLANT LIST

Key	Botanical Name	Common Name	Qty	Size	Conditions	Remarks
GB	Ginkgo biloba	Maidenhair Tree	3	50mm cal	WB	full crown
GT	Gleditsia triacanthos var. inermis 'Skycole'	Skyline® Honey Locust	9	50mm cal	WB	full crown

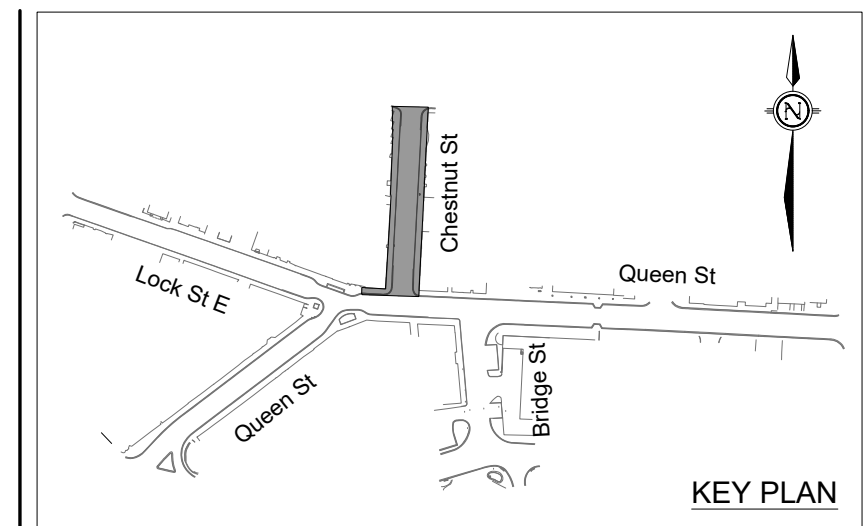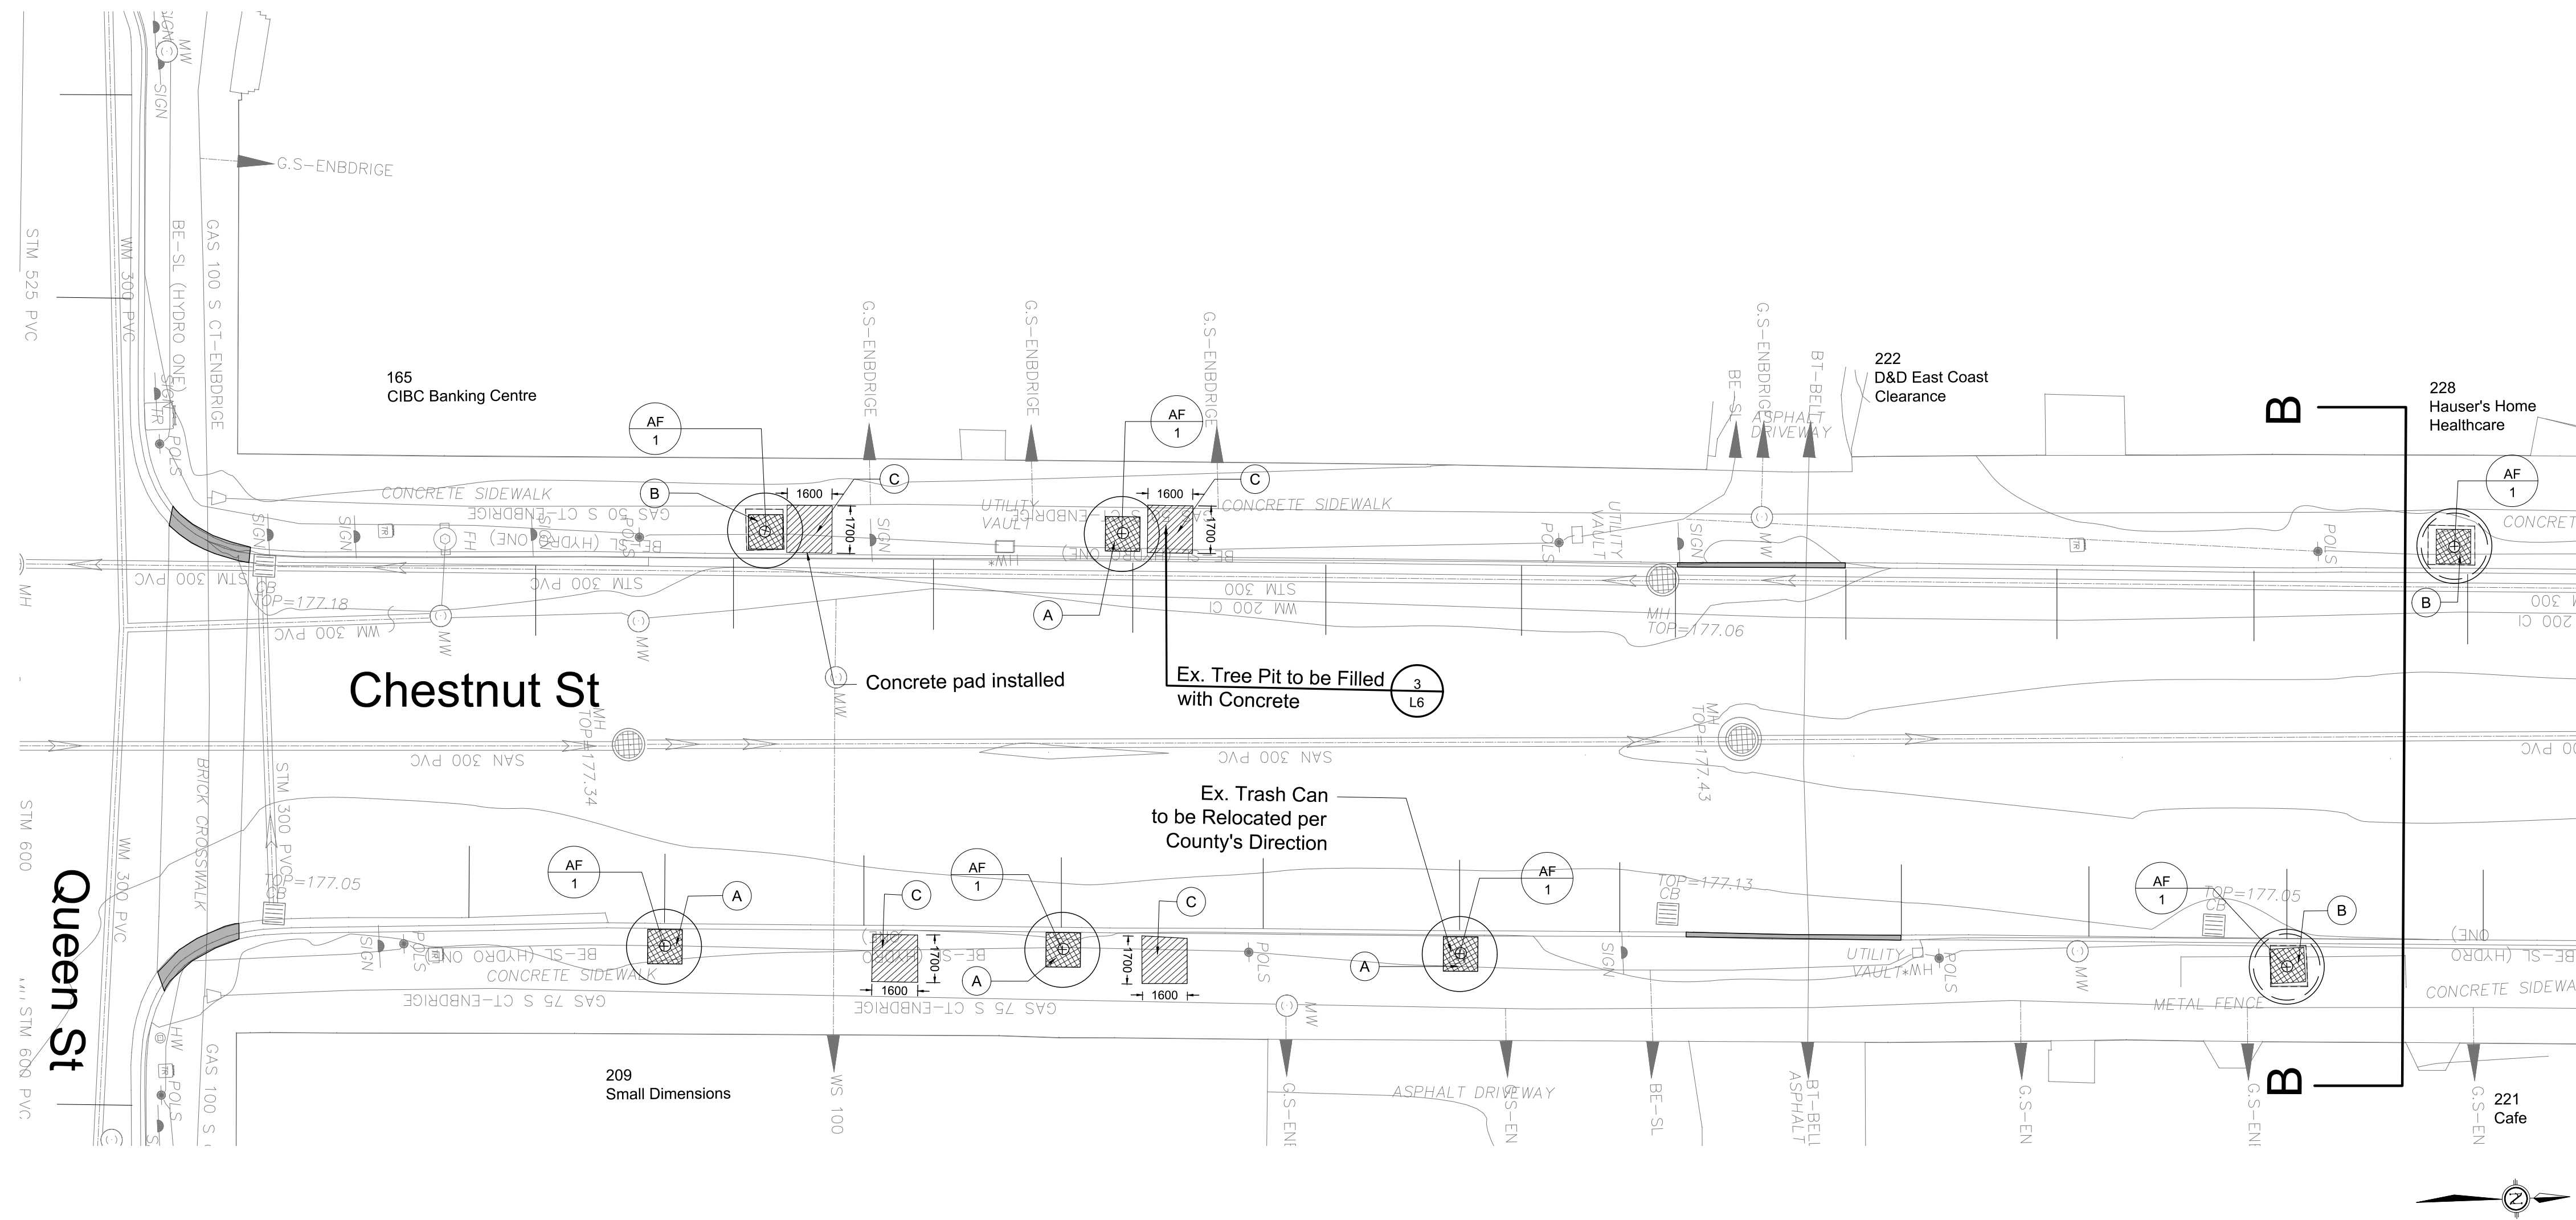

Legend

- Ex. Parking Signs to Remain Unless Otherwise Stated
- Ex. Street Light Standard to Remain Unless Otherwise Stated
- Ex. Outdoor Trash Can Unless Otherwise Stated
- Ex. Street Signs to Remain Unless Otherwise Stated
- Ex. Curb Cut to Remain Unless Otherwise Stated
- Ex. Tree in Turf to Remain
- Ex. Tree and Pit to be Removed
- Ex. Tree to be Replaced with Upgraded Pit
- Ex. Tree Pit to be Removed
- New Tree and Pit

Concrete-related Activities

- A New Tree Pit Location (existing concrete to be removed), refer to Detail 1, Sheet L6
- B Existing Tree Pit Location (new concrete to be placed to reconfigure tree pit opening size and/or to accept specified tree pit grate/guard), refer to Detail 2, Sheet L6
- C Removal of Existing Tree Pit (new concrete placed, capping former; to be flush with adjacent ex. sidewalk), refer to Detail 3, Sheet L6

Notes

1. The contractor shall check and verify all dimensions and conditions on the project and immediately report any discrepancies to the Landscape Architect before proceeding with work.
2. All dimensions are in millimeters unless otherwise stated.
3. The contractor shall layout the site and seek approval of the Landscape Architect prior to proceeding with work.
4. Project Boundary - Queen Street, Bridge Street, Lock Street East and Chestnut Street. Existing sidewalk and concrete curbs to remain undisturbed unless otherwise noted.

4	29 Feb. 2024	Revised - As Constructed Drawings
3	8 Mar. 2022	Revised - for County Review
2	10 Jan. 2022	For County Review
1	13 Dec. 2021	Review
No.	Date	Item

This drawing is an instrument of professional services and is intended for the use only in connection with the project covered by the consultant agreement.

Haldimand County
 53 Thorburn Street South, Cayuga, Ontario N0A 1E0


ska
 Stempski Kelly Associates Inc.
 Design Landscape Architecture Planning
 P.O. Box 399, Fergus, ON. N1M 3E2
 Voice (519) 787 4313
 sean@ska-design.ca www.ska-design.ca

Project Title
Dunnville Downtown Street Tree Planting
 Queen Street, Bridge Street, Lock Street East and Chestnut Street, Dunnville ON

JY/TV
 Drawn
 SK
 Checked
 #
 Project No.
 February 2024
 Date

Sheet Title
Chestnut St - Streetscape Improvement Plan
 Scale
 1:150



Sheet No.
L1

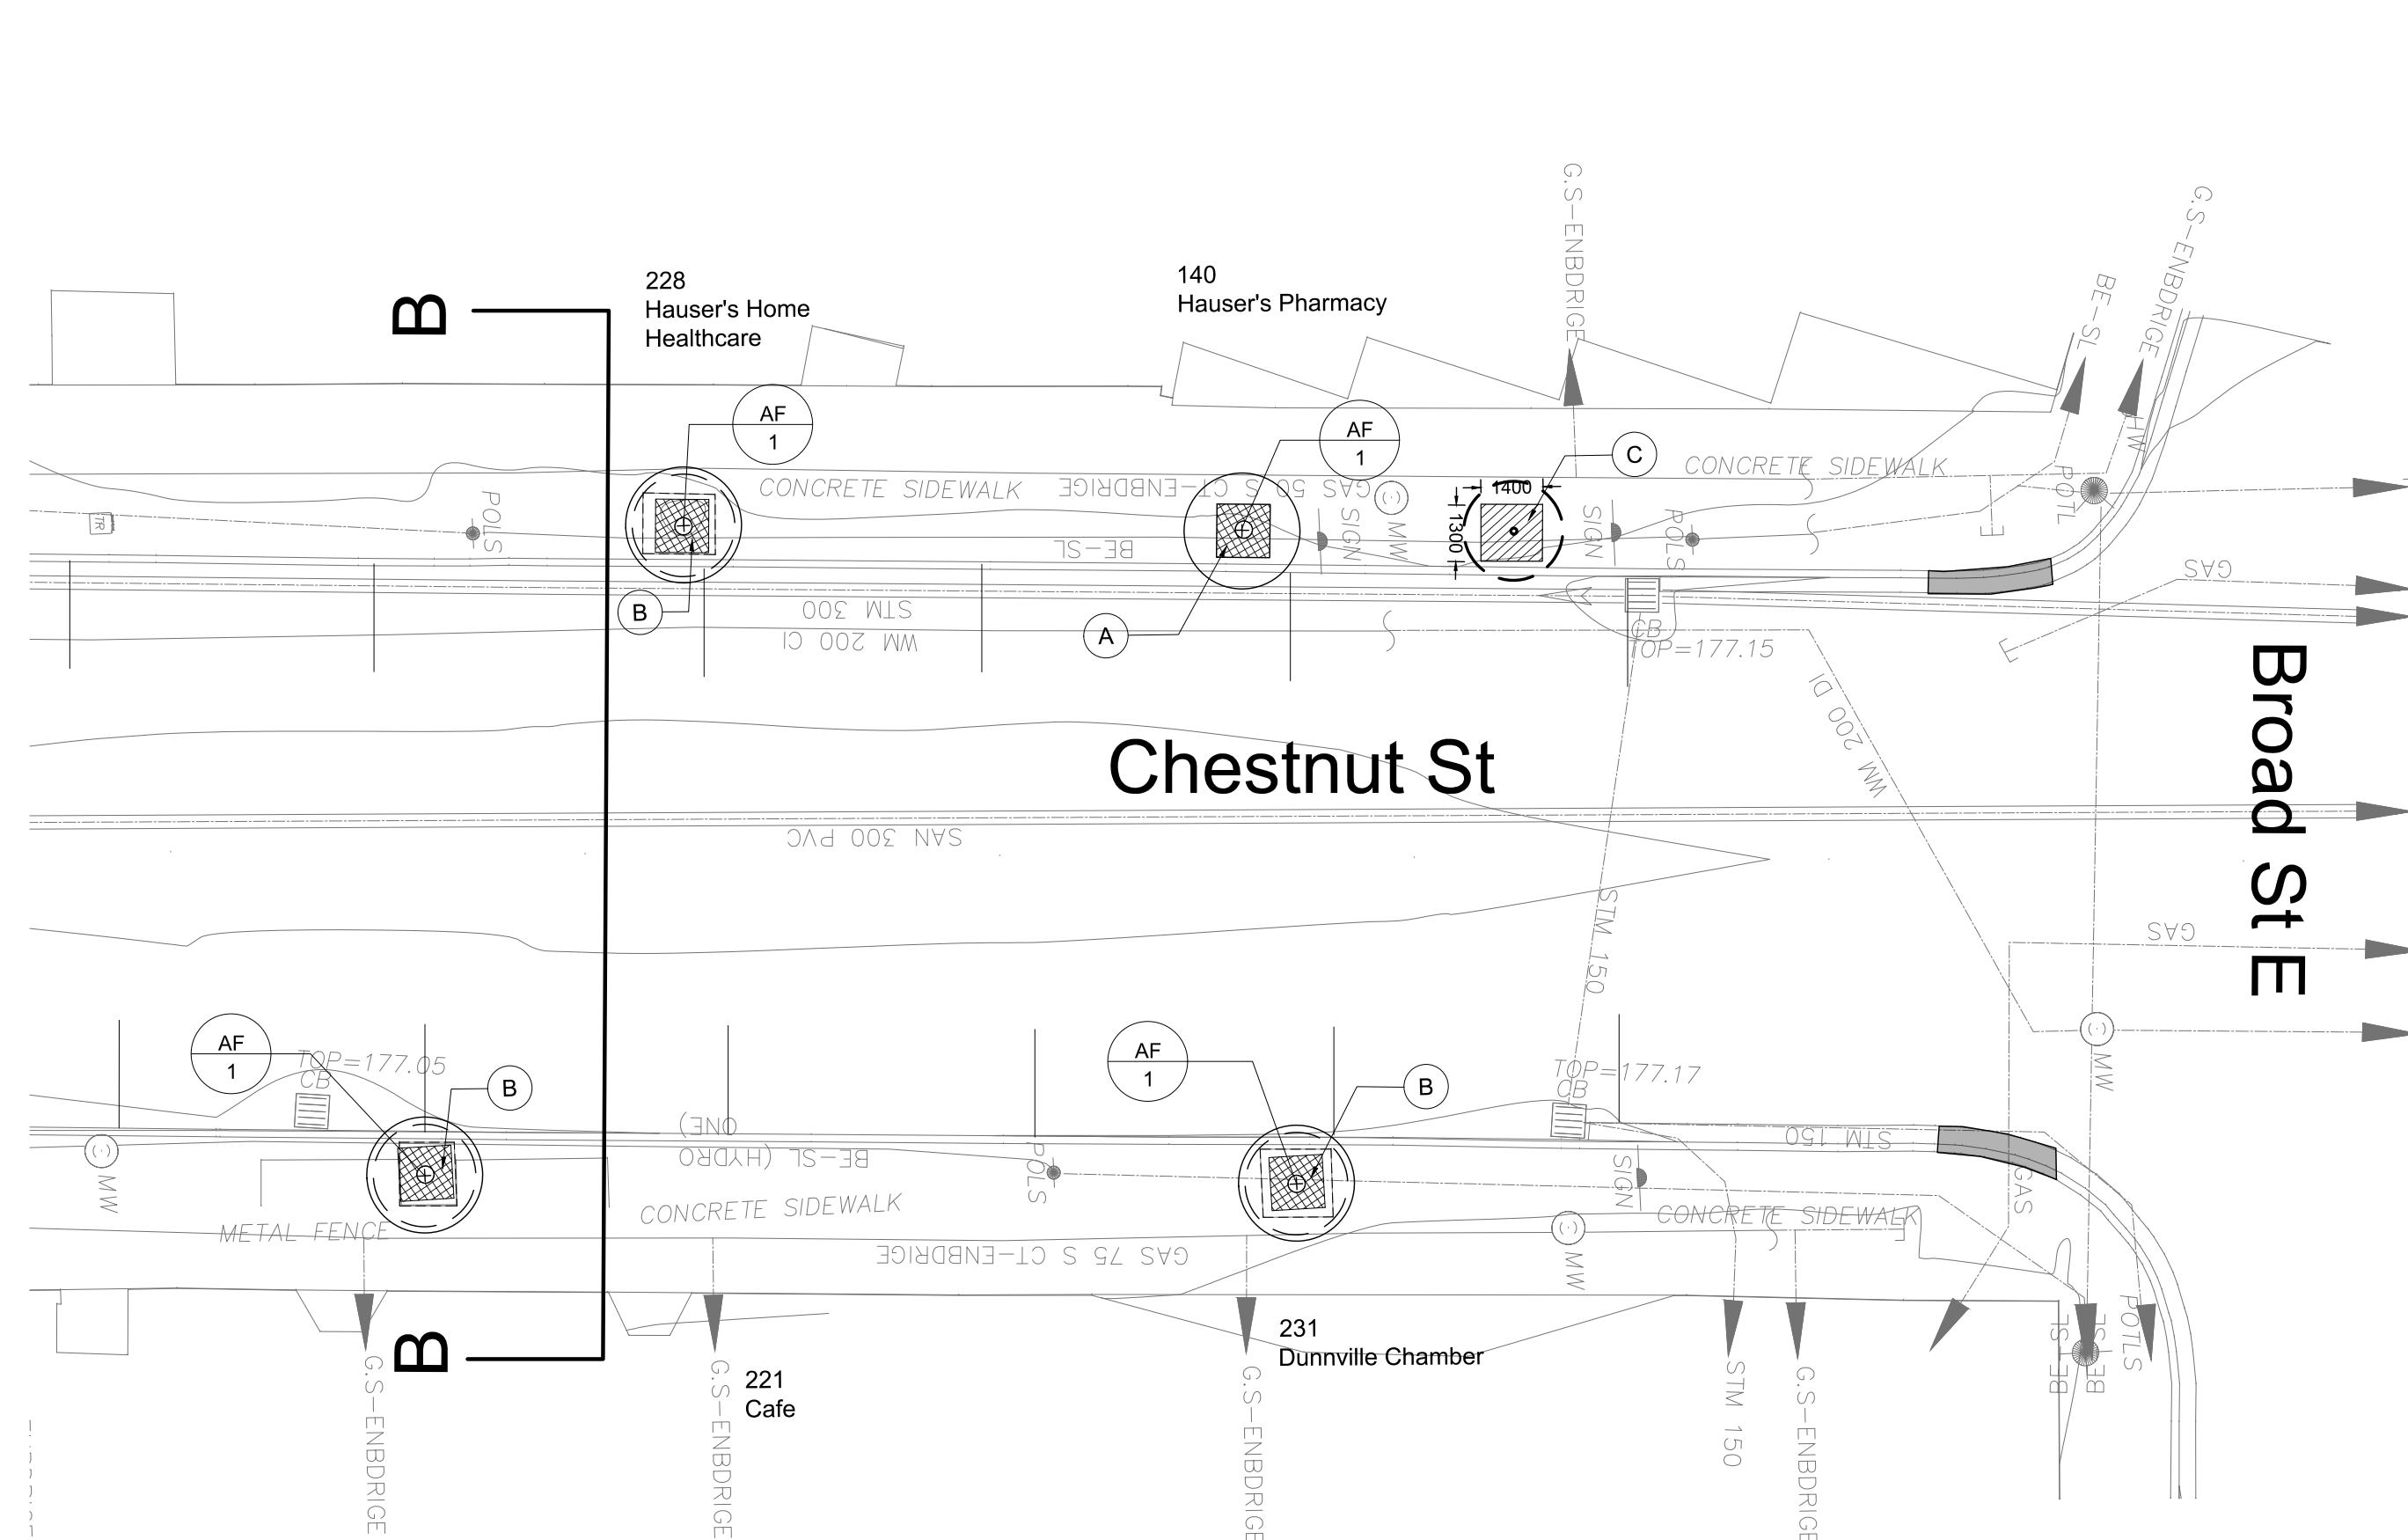

As Constructed
 Per Site Review 28 Feb 2024

PLANT LIST

Key	Botanical Name	Common Name	Qty	Size	Conditions	Remarks
Deciduous Trees						
AF	Acer x freemanii Celebration	Celebration Maple	9	50mm cal	WB	full crown

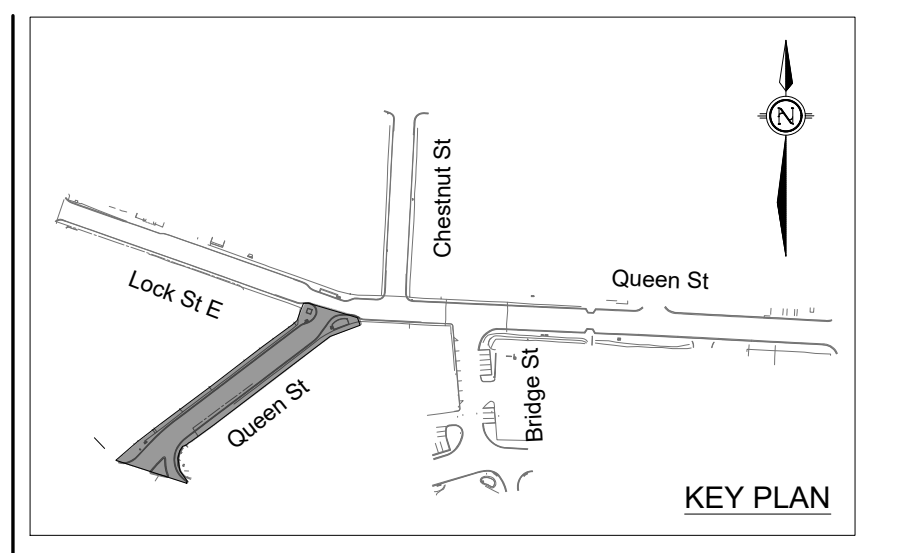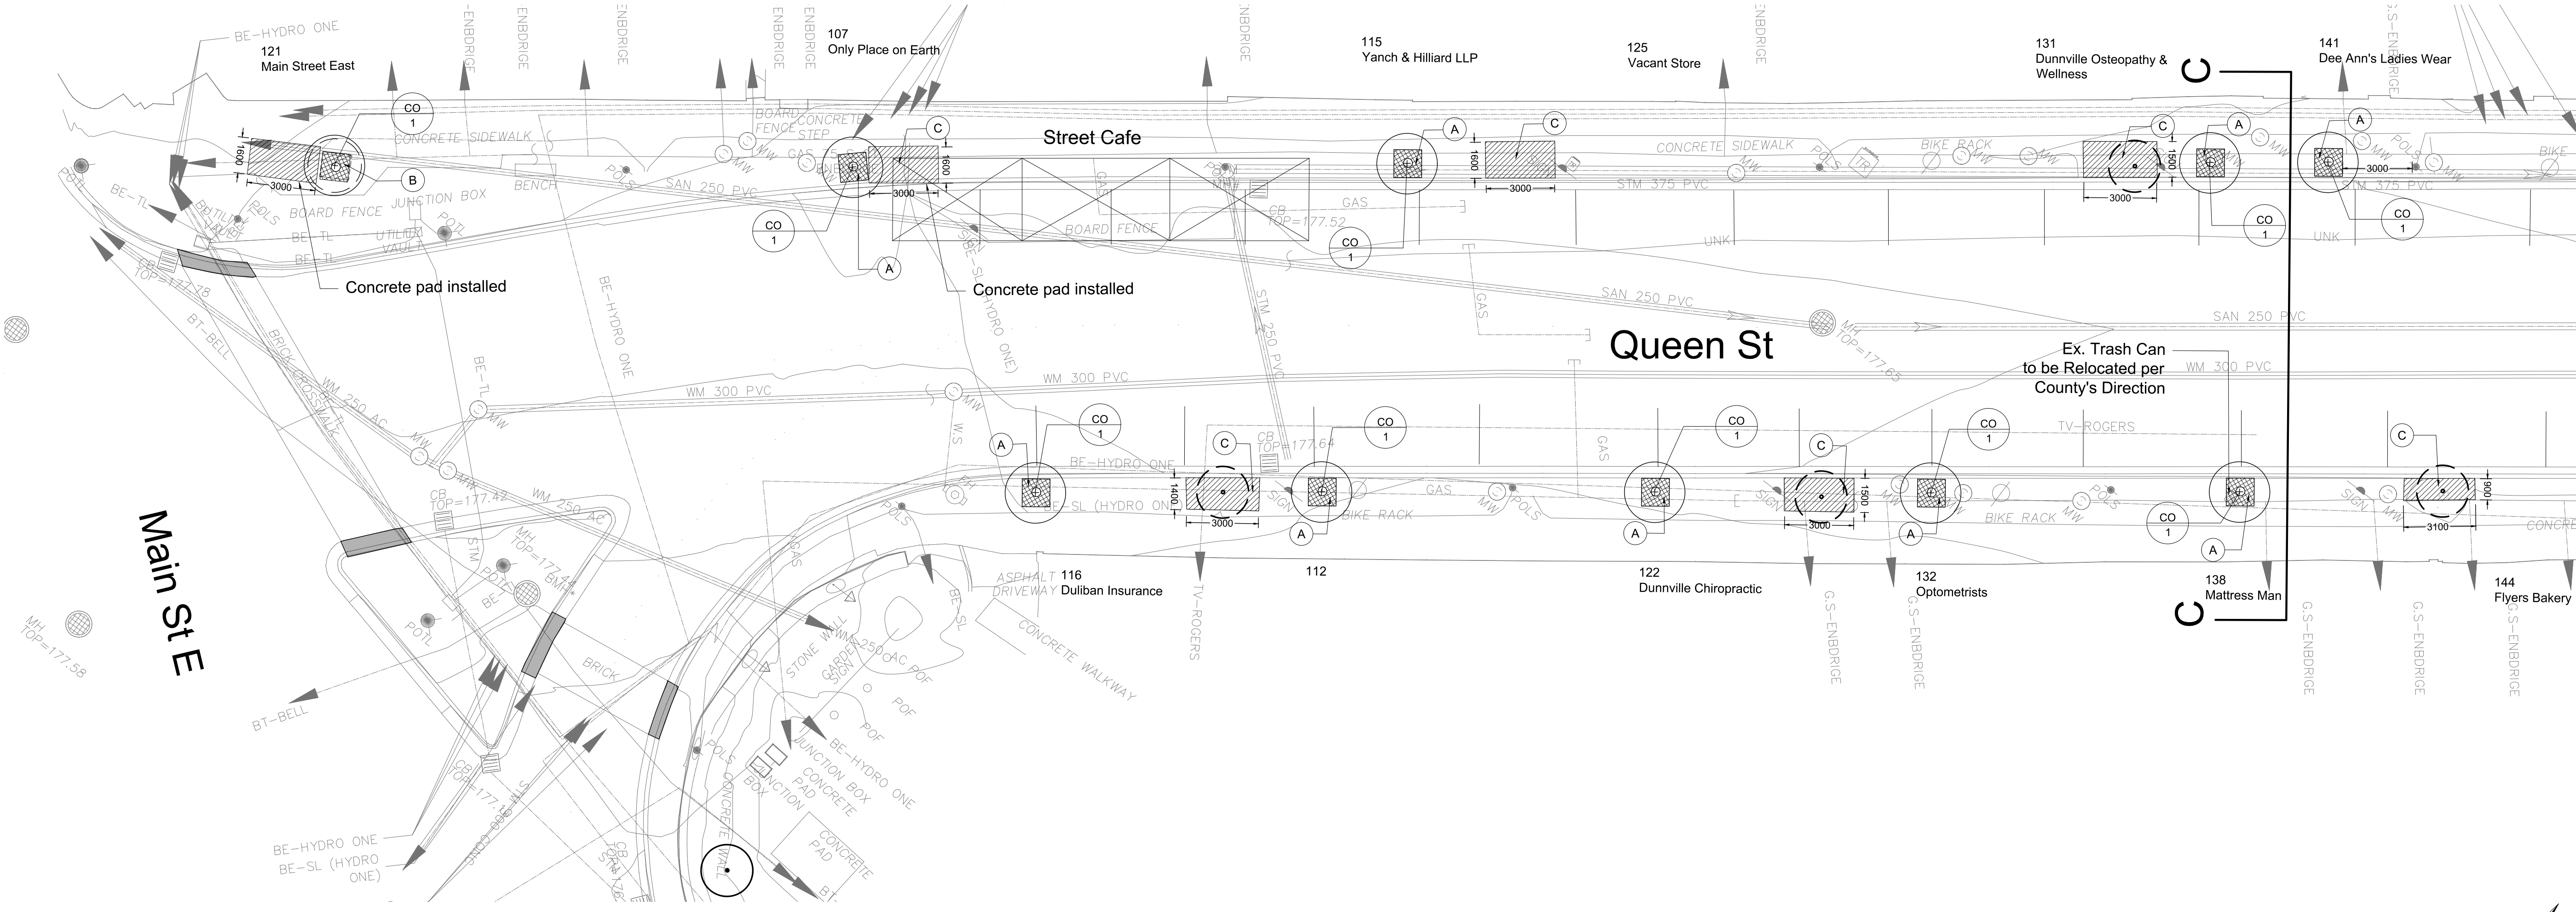

- Legend**
- Ex. Parking Signs to Remain Unless Otherwise Stated
 - Ex. Tree in Turf to Remain
 - Ex. Street Light Standard to Remain Unless Otherwise Stated
 - Ex. Tree and Pit to be Removed
 - Ex. Outdoor Trash Can Unless Otherwise Stated
 - Ex. Tree to be Replaced with Upgraded Pit
 - Ex. Street Signs to Remain Unless Otherwise Stated
 - Ex. Tree Pit to be Removed
 - Ex. Curb Cut to Remain Unless Otherwise Stated
 - New Tree and Pit
- Concrete-related Activities**
- A** New Tree Pit Location (existing concrete to be removed), refer to Detail 1, Sheet L6
 - B** Existing Tree Pit Location (new concrete to be placed to reconfigure tree pit opening size and/or to accept specified tree pit grate/guard), refer to Detail 2, Sheet L6
 - C** Removal of Existing Tree Pit (new concrete placed, capping former; to be flush with adjacent ex. sidewalk), refer to Detail 3, Sheet L6

- Notes**
- The contractor shall check and verify all dimensions and conditions on the project and immediately report any discrepancies to the Landscape Architect before proceeding with work.
 - All dimensions are in millimeters unless otherwise stated.
 - The contractor shall layout the site and seek approval of the Landscape Architect prior to proceeding with work.
 - Project Boundary - Queen Street, Bridge Street, Lock Street East and Chestnut Street. Existing sidewalk and concrete curbs to remain undisturbed unless otherwise noted.


4	29 Feb. 2024	Revised - As Constructed Drawings
3	8 Mar. 2022	Revised - for County Review
2	10 Jan. 2022	For County Review
1	13 Dec. 2021	Review
No.	Date	Item

Revisions

This drawing is an instrument of professional services and is intended for the use only in connection with the project covered by the consultant agreement.

Haldimand County
 53 Thorburn Street South, Cayuga, Ontario N0A 1E0

As Constructed
 Per Site Review 28 Feb 2024

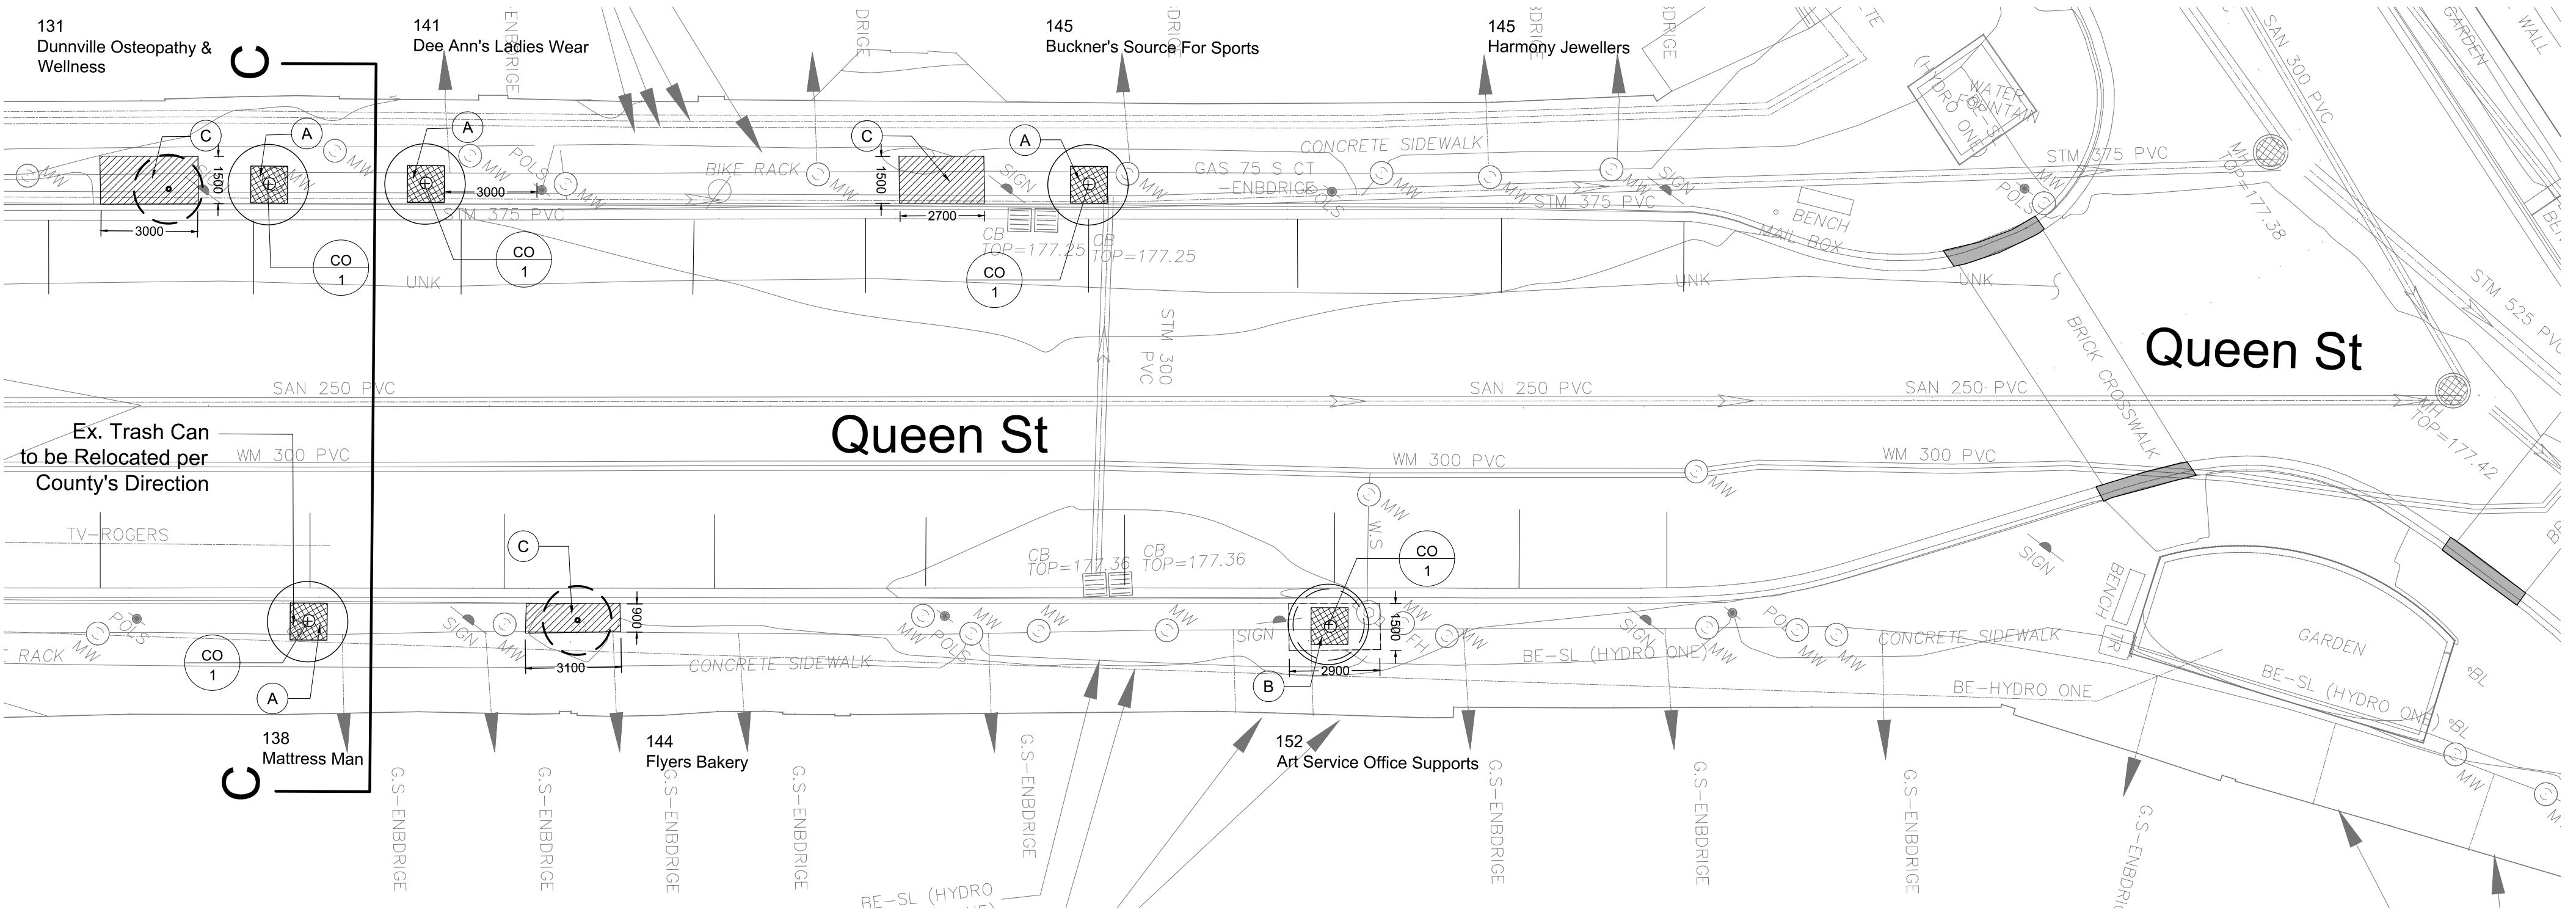

PLANT LIST

Key	Botanical Name	Common Name	Qty	Size	Conditions	Remarks
Deciduous Trees						
CO	Celtis occidentalis	Hackberry	12	50mm cal	WB	full crown



ska
 Stempski Kelly Associates Inc.
 Design Landscape Architecture Planning
 P.O. Box 399, Fergus, ON, N1M 3E2
 Voice (519) 787 4313
 sean@ska-design.ca www.ska-design.ca

Project Title
Dunnville Downtown Street Tree Planting
 Queen Street, Bridge Street, Lock Street East and Chestnut Street, Dunnville ON

JY/TV
 Drawn
 SK
 Checked
 #
 Project No.
 February 2024
 Date

Sheet Title
 Queen St. - Streetscape Improvement Plan
 Scale
 1:150

Sheet No.
L2

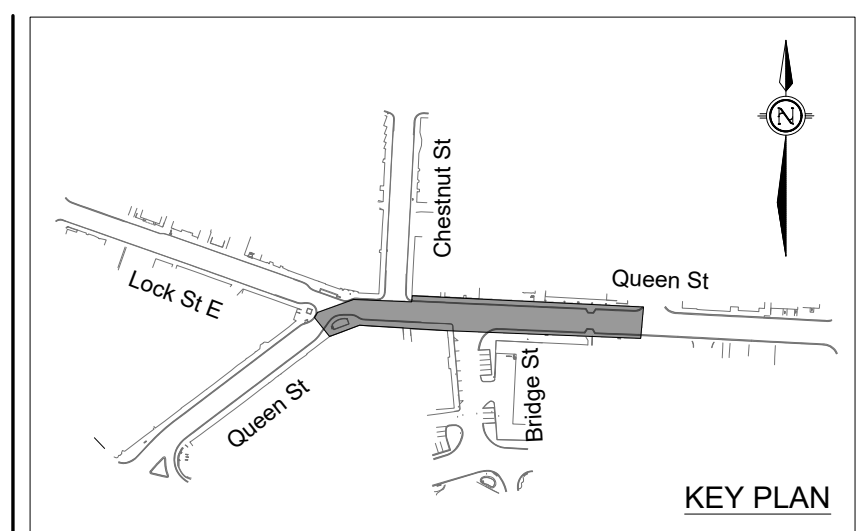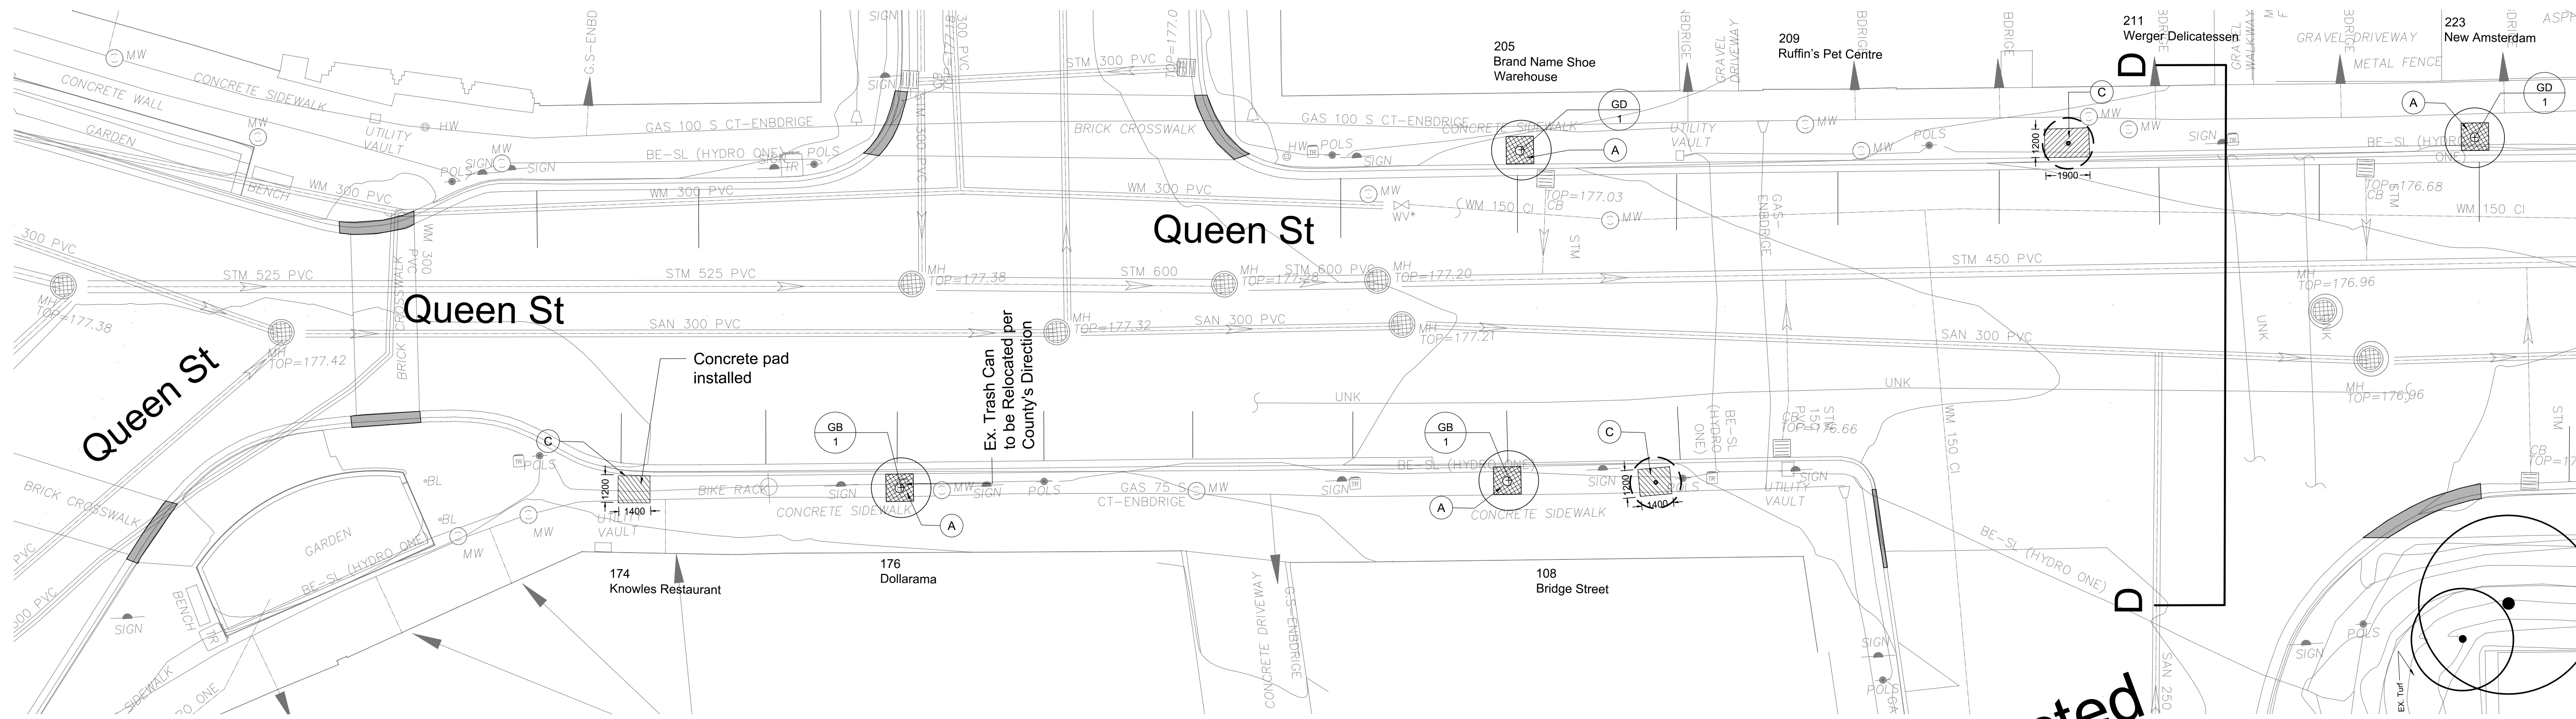


- Legend**
- Ex. Parking Signs to Remain Unless Otherwise Stated
 - Ex. Tree in Turf to Remain
 - Ex. Tree and Pit to be Removed
 - Ex. Tree to be Replaced with Upgraded Pit
 - Ex. Tree Pit to be Removed
 - New Tree and Pit
 - Ex. Street Light Standard to Remain Unless Otherwise Stated
 - Ex. Outdoor Trash Can Unless Otherwise Stated
 - Ex. Street Signs to Remain Unless Otherwise Stated
 - Ex. Curb Cut to Remain Unless Otherwise Stated

- Concrete-related Activities**
- A** New Tree Pit Location (existing concrete to be removed), refer to Detail 1, Sheet L6
 - B** Existing Tree Pit Location (new concrete to be placed to reconfigure tree pit opening size and/or to accept specified tree pit grate/guard), refer to Detail 2, Sheet L6
 - C** Removal of Existing Tree Pit (new concrete placed, capping former; to be flush with adjacent ex. sidewalk), refer to Detail 3, Sheet L6

- Notes**
- The contractor shall check and verify all dimensions and conditions on the project and immediately report any discrepancies to the Landscape Architect before proceeding with work.
 - All dimensions are in millimeters unless otherwise stated.
 - The contractor shall layout the site and seek approval of the Landscape Architect prior to proceeding with work.
 - Project Boundary - Queen Street, Bridge Street, Lock Street East and Chestnut Street. Existing sidewalk and concrete curbs to remain undisturbed unless otherwise noted.

As Constructed
Per Site Review 28 Feb 2024

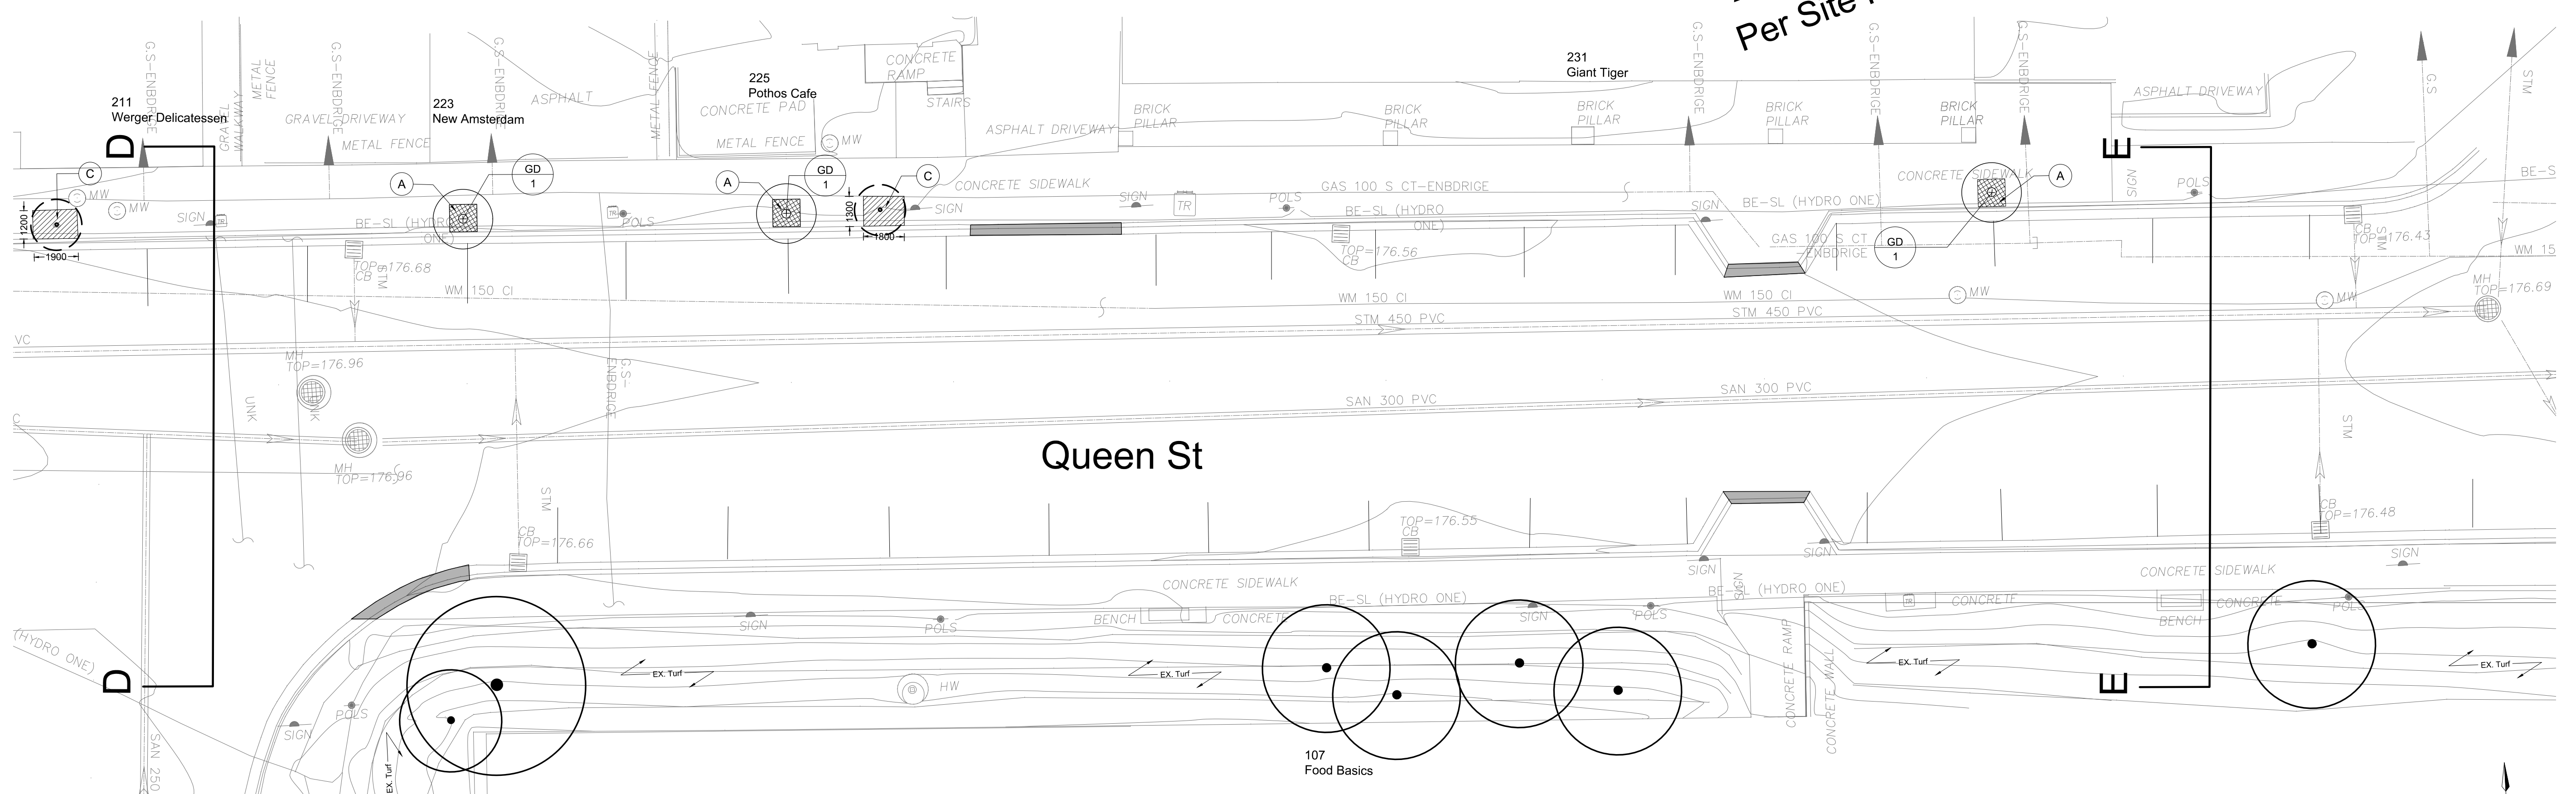

PLANT LIST

Key	Botanical Name	Common Name	Qty	Size	Conditions	Remarks
GB	Ginkgo biloba	Maidenhair Tree	2	50mm cal	WB	full crown
GD	Gymnocladus dioicis 'Espresso-JFS'	Espresso Kentucky Coffeetree	4	50mm cal	WB	full crown

No.	Date	Item
4	29 Feb. 2024	Revised - As Constructed Drawings
3	8 Mar. 2022	Revised - for County Review
2	10 Jan. 2022	For County Review
1	13 Dec. 2021	Review

This drawing is an instrument of professional services and is intended for the use only in connection with the project covered by the consultant agreement.

Haldimand County
53 Thorburn Street South, Cayuga, Ontario N0A 1E0

ska
Stempski Kelly Associates Inc.
Design Landscape Architecture Planning
P.O. Box 399, Fergus, ON. N1M 3E2
Voice (519) 787 4313
sean@ska-design.ca www.ska-design.ca



Project Title
Dunnville Downtown Street Tree Planting
Queen Street, Bridge Street, Lock Street East and Chestnut Street, Dunnville ON

JY/TV
Drawn
SK
Checked


Project No.
February 2024
Date

Sheet Title
Queen St. - Streetscape Improvement Plan
Scale
1:150

Sheet No.
L3

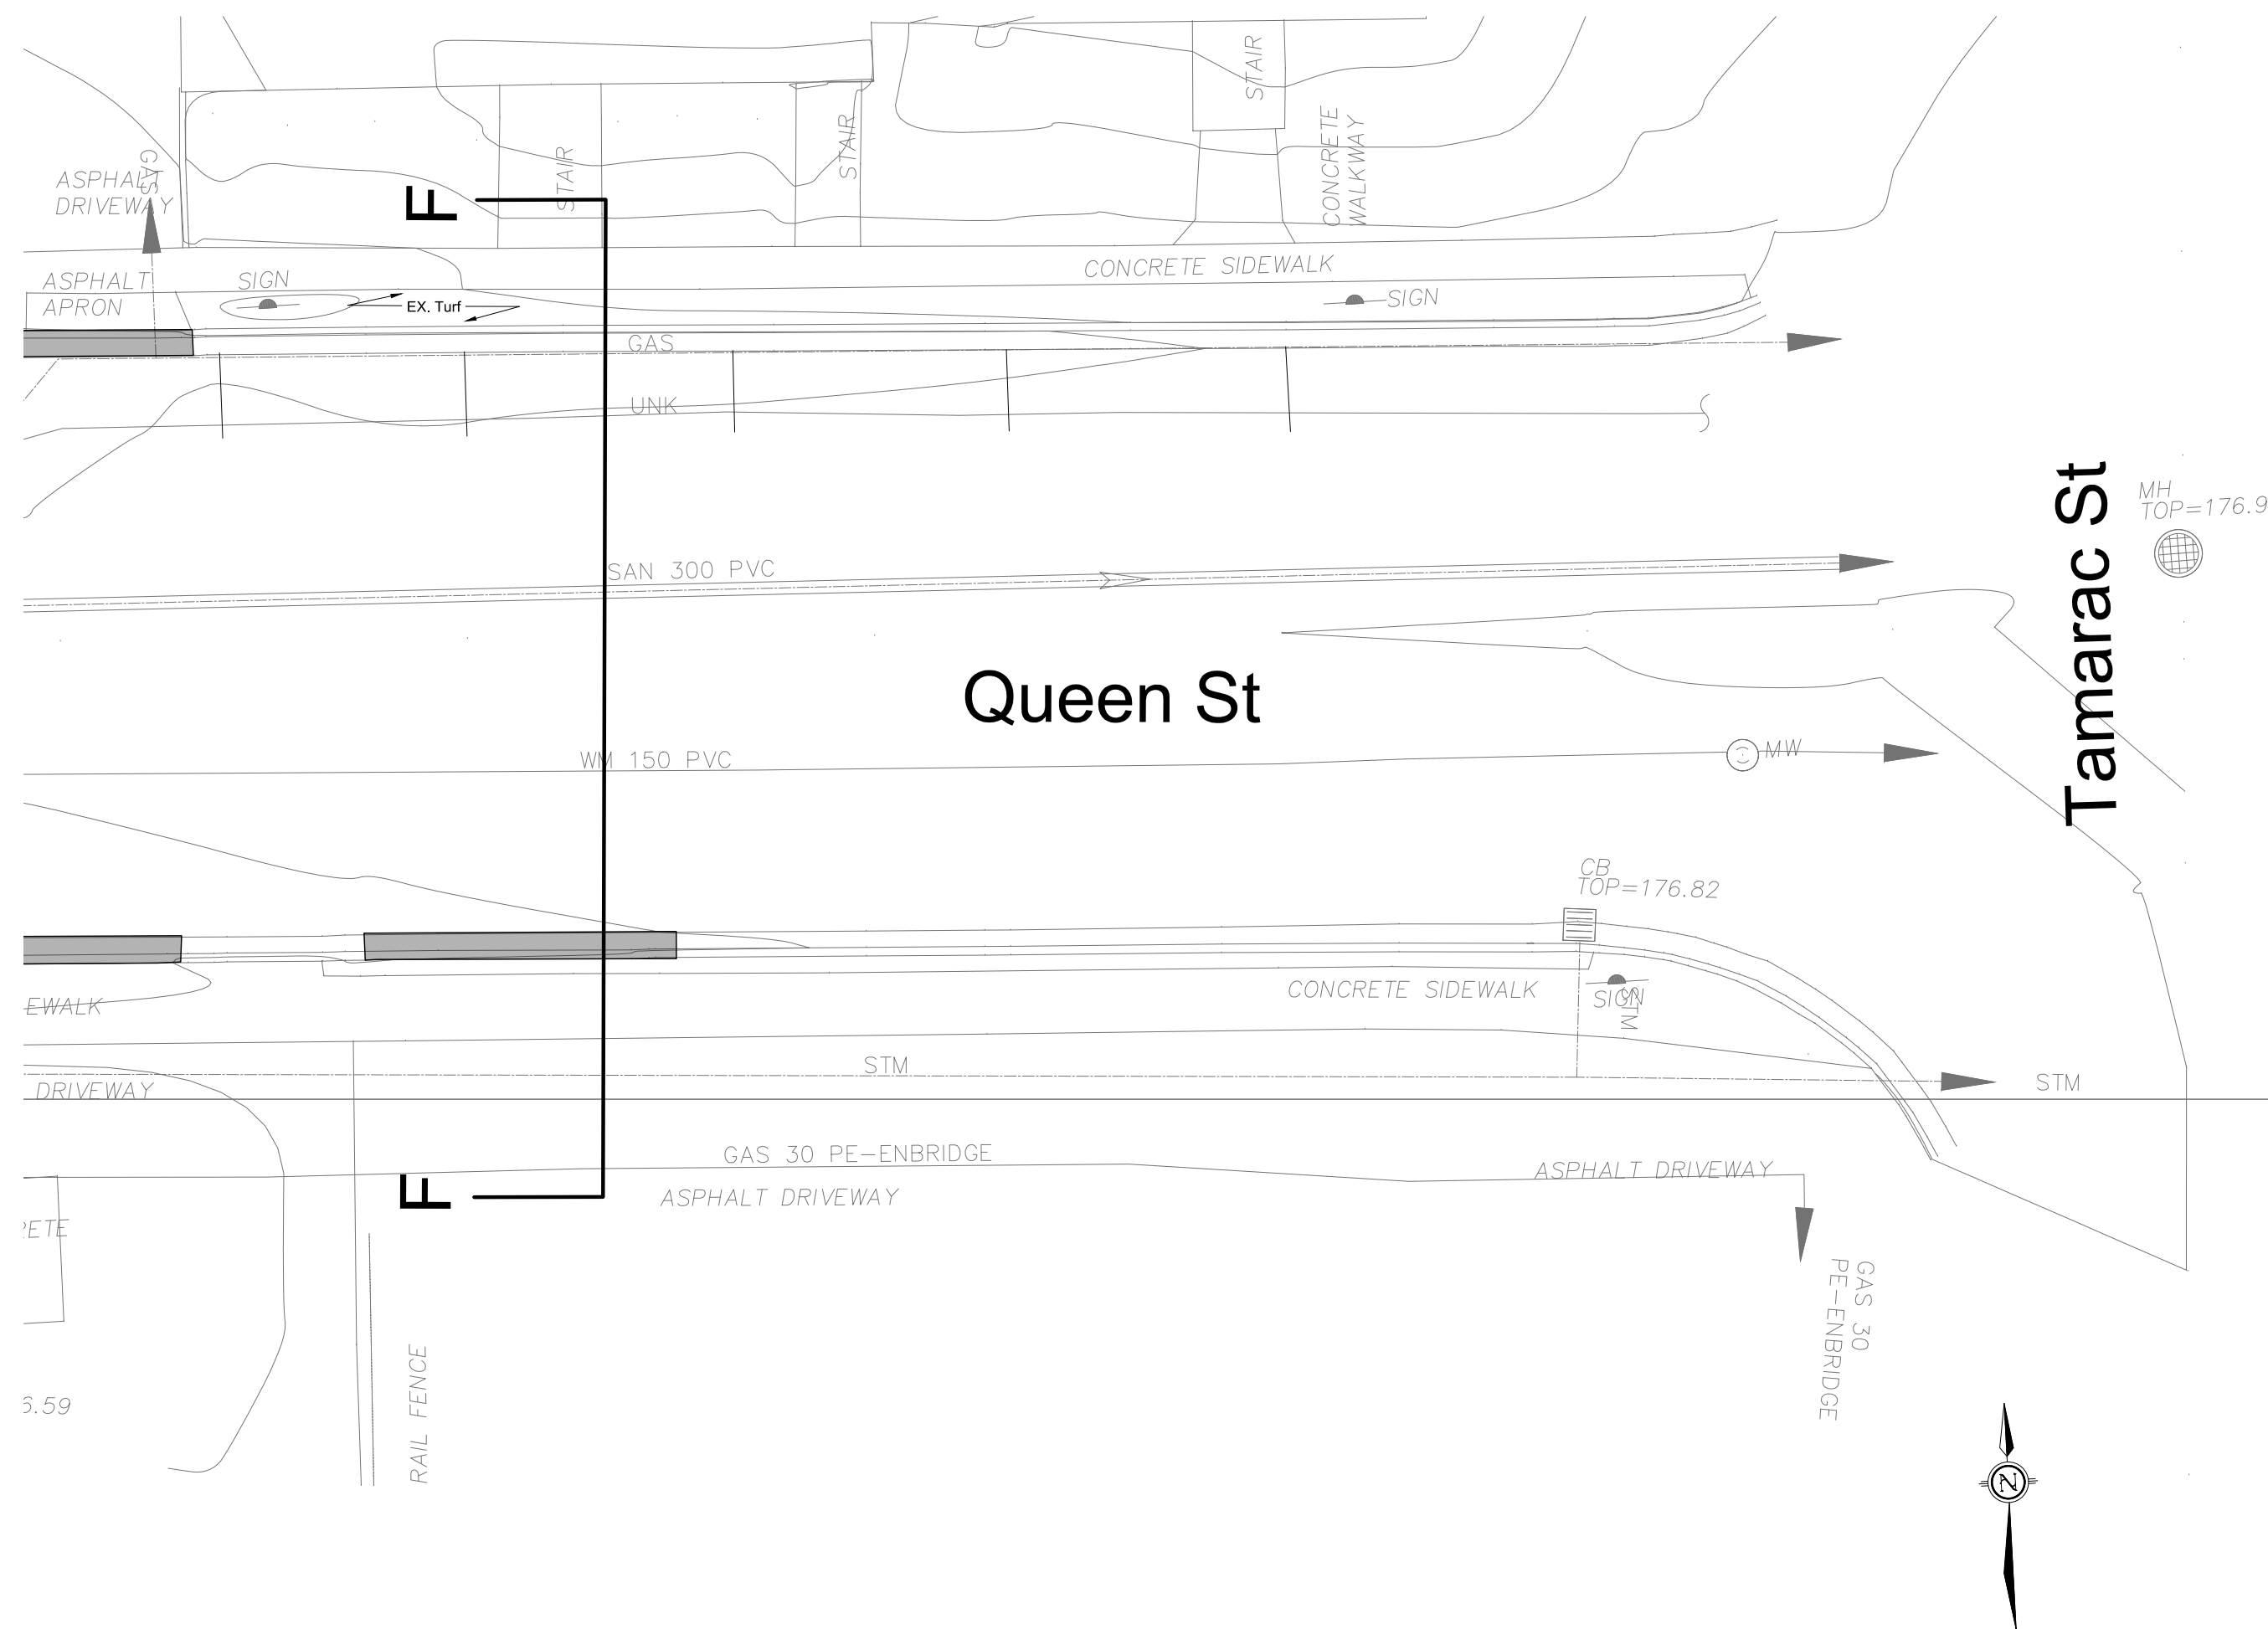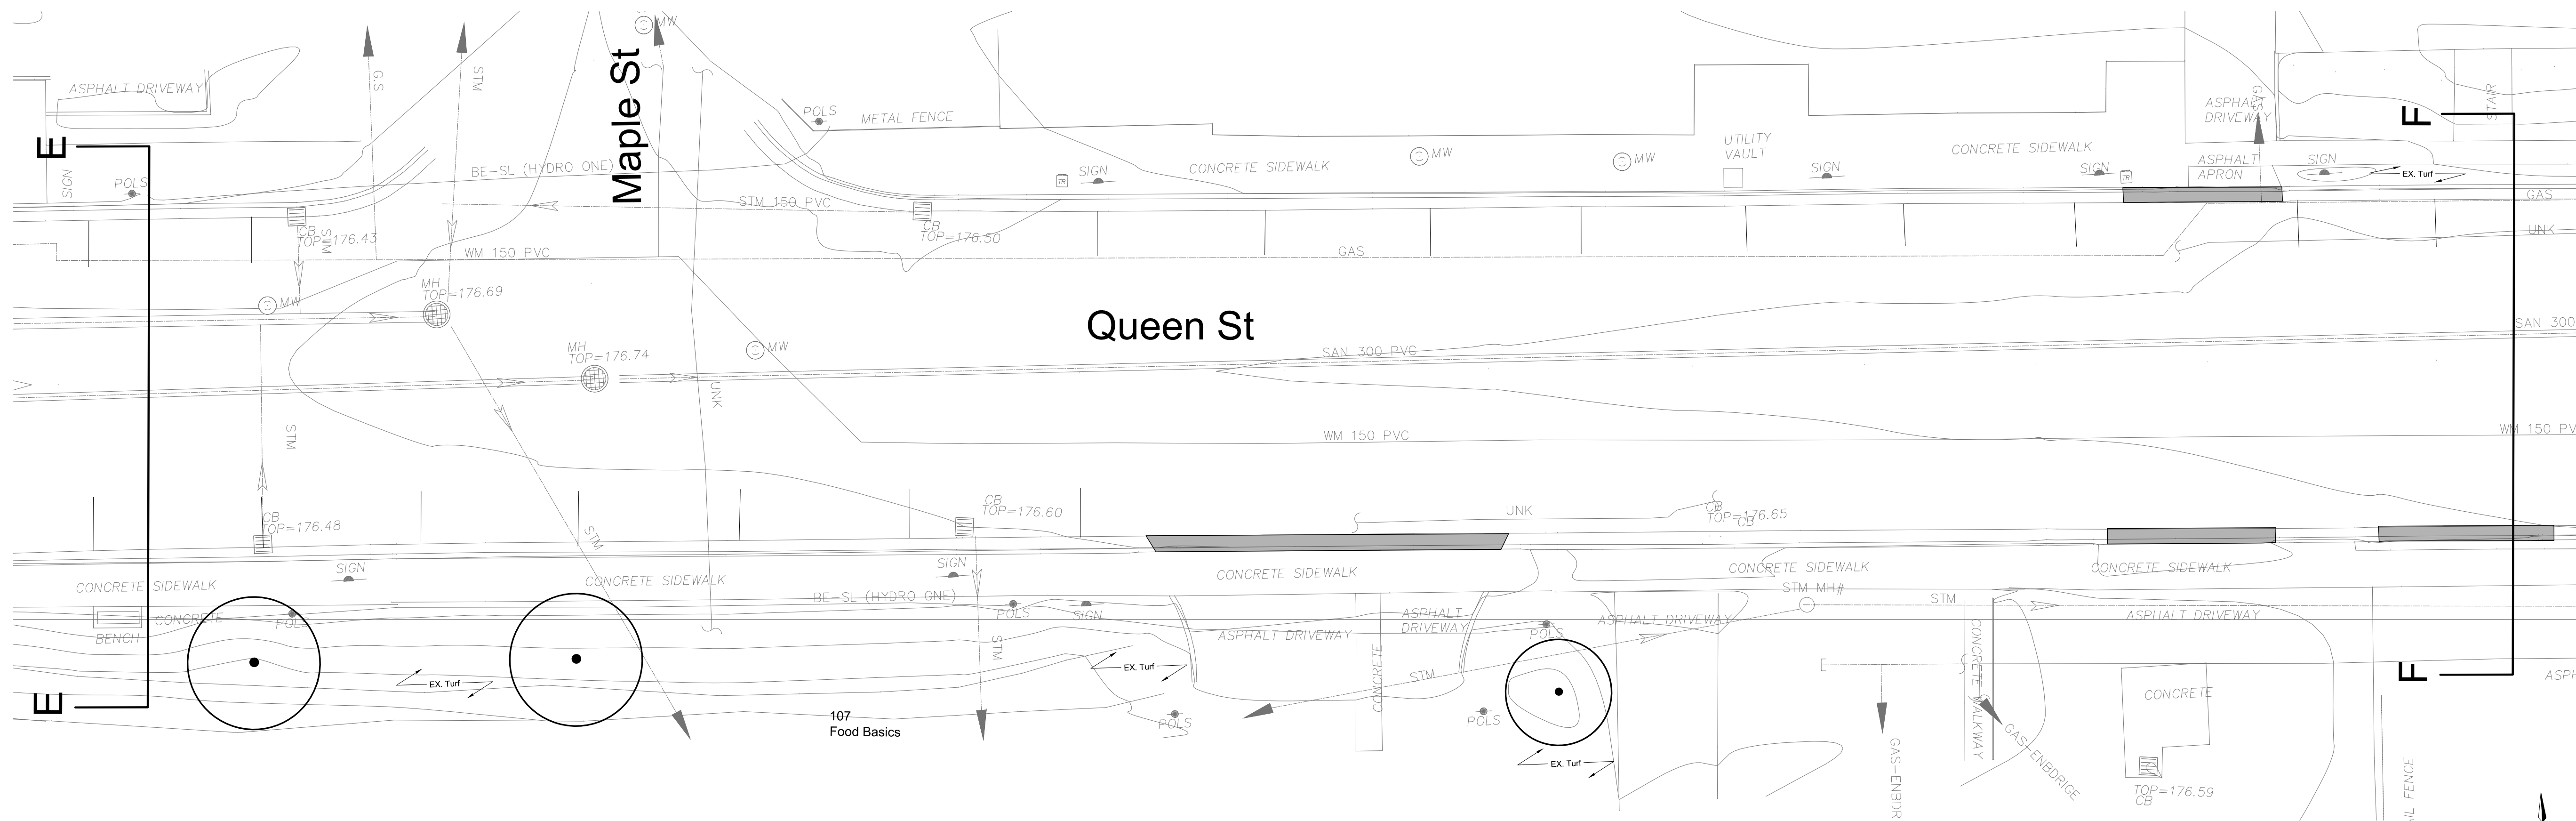

As Constructed
Per Site Review 28 Feb 2024

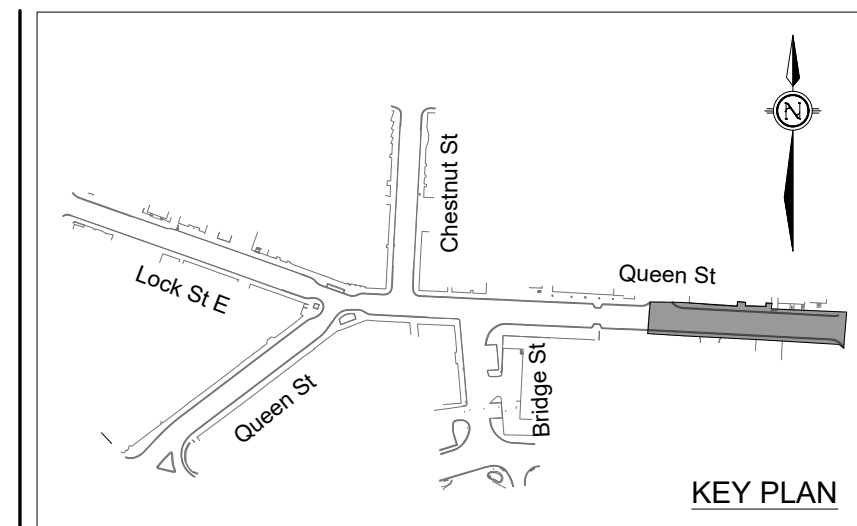

Legend

- Ex. Parking Signs to Remain Unless Otherwise Stated
- Ex. Tree in Turf to Remain
- Ex. Tree and Pit to be Removed
- Ex. Tree to be Replaced with Upgraded Pit
- Ex. Tree Pit to be Removed
- New Tree and Pit
- Ex. Street Light Standard to Remain Unless Otherwise Stated
- Ex. Outdoor Trash Can Unless Otherwise Stated
- Ex. Street Signs to Remain Unless Otherwise Stated
- Ex. Curb Cut to Remain Unless Otherwise Stated

Concrete-related Activities

- A** New Tree Pit Location (existing concrete to be removed), refer to Detail 1, Sheet L6
- B** Existing Tree Pit Location (new concrete to be placed to reconfigure tree pit opening size and/or to accept specified tree pit grate/guard), refer to Detail 2, Sheet L6
- C** Removal of Existing Tree Pit (new concrete placed, capping former; to be flush with adjacent ex. sidewalk), refer to Detail 3, Sheet L6

Notes

1. The contractor shall check and verify all dimensions and conditions on the project and immediately report any discrepancies to the Landscape Architect before proceeding with work.
2. All dimensions are in millimeters unless otherwise stated.
3. The contractor shall layout the site and seek approval of the Landscape Architect prior to proceeding with work.
4. Project Boundary - Queen Street, Bridge Street, Lock Street East and Chestnut Street. Existing sidewalk and concrete curbs to remain undisturbed unless otherwise noted.

No.	Date	Item
4	29 Feb. 2024	Revised - As Constructed Drawings
3	8 Mar. 2022	Revised - for County Review
2	10 Jan. 2022	For County Review
1	13 Dec. 2021	Review

This drawing is an instrument of professional services and is intended for the use only in connection with the project covered by the consultant agreement.

Haldimand County
53 Thorburn Street South, Cayuga, Ontario N0A 1E0

ska
Stempski Kelly Associates Inc.
Design Landscape Architecture Planning
P.O. Box 399, Fergus, ON. N1M 3E2
Voice (519) 787 4313
sean@ska-design.ca www.ska-design.ca



Project Title
Dunnville Downtown Street Tree Planting
Queen Street, Bridge Street, Lock Street East and Chestnut Street, Dunnville ON

JY/TV
Drawn
SK
Checked

Project No.
February 2024
Date

Sheet Title
Queen St. - Streetscape Improvement Plan
Scale
1:150

Sheet No.
L4

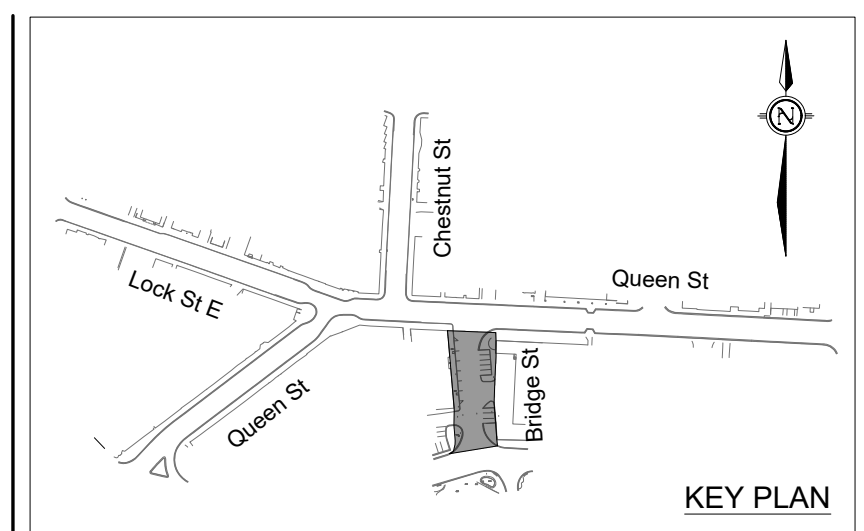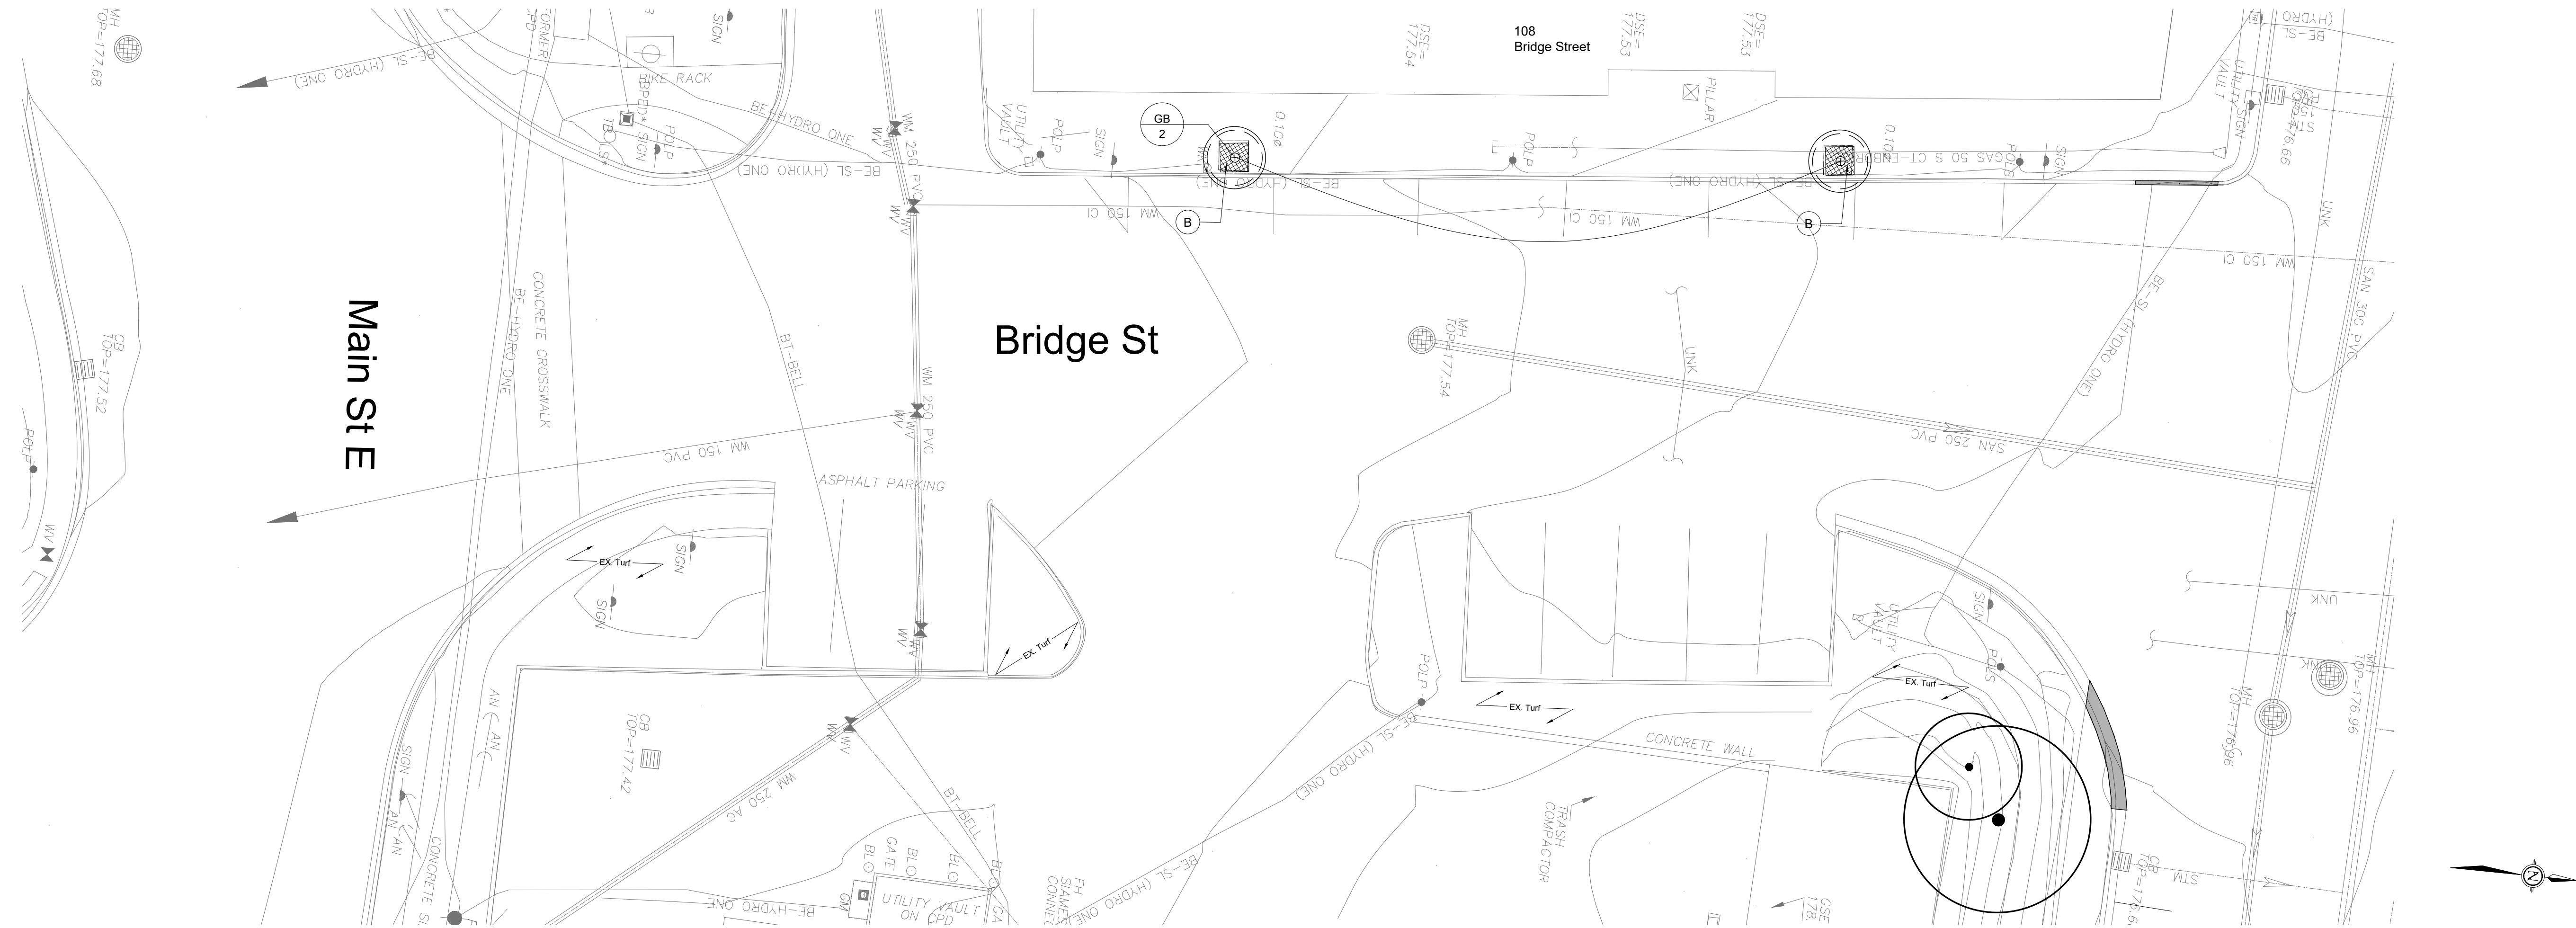

- Legend**
- Ex. Parking Signs to Remain Unless Otherwise Stated
 - Ex. Tree in Turf to Remain
 - Ex. Street Light Standard to Remain Unless Otherwise Stated
 - Ex. Outdoor Trash Can Unless Otherwise Stated
 - Ex. Street Signs to Remain Unless Otherwise Stated
 - Ex. Curb Cut to Remain Unless Otherwise Stated
 - Ex. Tree and Pit to be Removed
 - Ex. Tree to be Replaced with Upgraded Pit
 - Ex. Tree Pit to be Removed
 - New Tree and Pit
- Concrete-related Activities**
- A** New Tree Pit Location (existing concrete to be removed), refer to Detail 1, Sheet L6
 - B** Existing Tree Pit Location (new concrete to be placed to reconfigure tree pit opening size and/or to accept specified tree pit grate/guard), refer to Detail 2, Sheet L6
 - C** Removal of Existing Tree Pit (new concrete placed, capping former; to be flush with adjacent ex. sidewalk), refer to Detail 3, Sheet L6


- Notes**
- The contractor shall check and verify all dimensions and conditions on the project and immediately report any discrepancies to the Landscape Architect before proceeding with work.
 - All dimensions are in millimeters unless otherwise stated.
 - The contractor shall layout the site and seek approval of the Landscape Architect prior to proceeding with work.
 - Project Boundary - Queen Street, Bridge Street, Lock Street East and Chestnut Street. Existing sidewalk and concrete curbs to remain undisturbed unless otherwise noted.

4	29 Feb. 2024	Revised - As Constructed Drawings
3	8 Mar. 2022	Revised - for County Review
2	10 Jan. 2022	For County Review
1	13 Dec. 2021	Review

No. | Date | Item

Revisions

This drawing is an instrument of professional services and is intended for the use only in connection with the project covered by the consultant agreement.

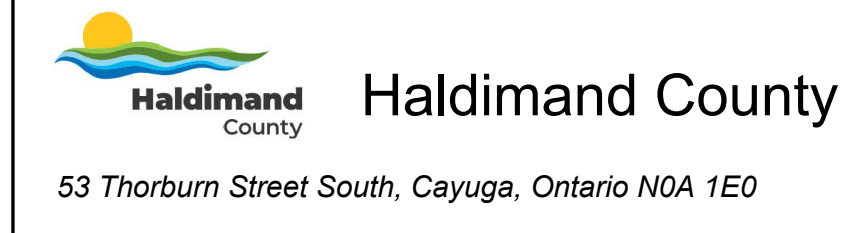

ska
 Stempski Kelly Associates Inc.
 Design Landscape Architecture Planning
 P.O. Box 399, Fergus, ON. N1M 3E2
 Voice (519) 787 4313
 sean@ska-design.ca www.ska-design.ca

Project Title
Dunnville Downtown Street Tree Planting
 Queen Street, Bridge Street, Lock Street East and Chestnut Street, Dunnville ON

JY/TV
 Drawn
 SK
 Checked
 #
 Project No.
 February 2024
 Date


Sheet Title
Bridge St. - Streetscape Improvement Plan
 Scale
 1:150

Sheet No.
L5

PLANT LIST


Key	Botanical Name	Common Name	Qty	Size	Conditions	Remarks
Deciduous Trees						
GB	Ginkgo biloba	Maidenhair Tree	2	50mm cal	WB	full crown

As Constructed
 Per Site Review 28 Feb 2024

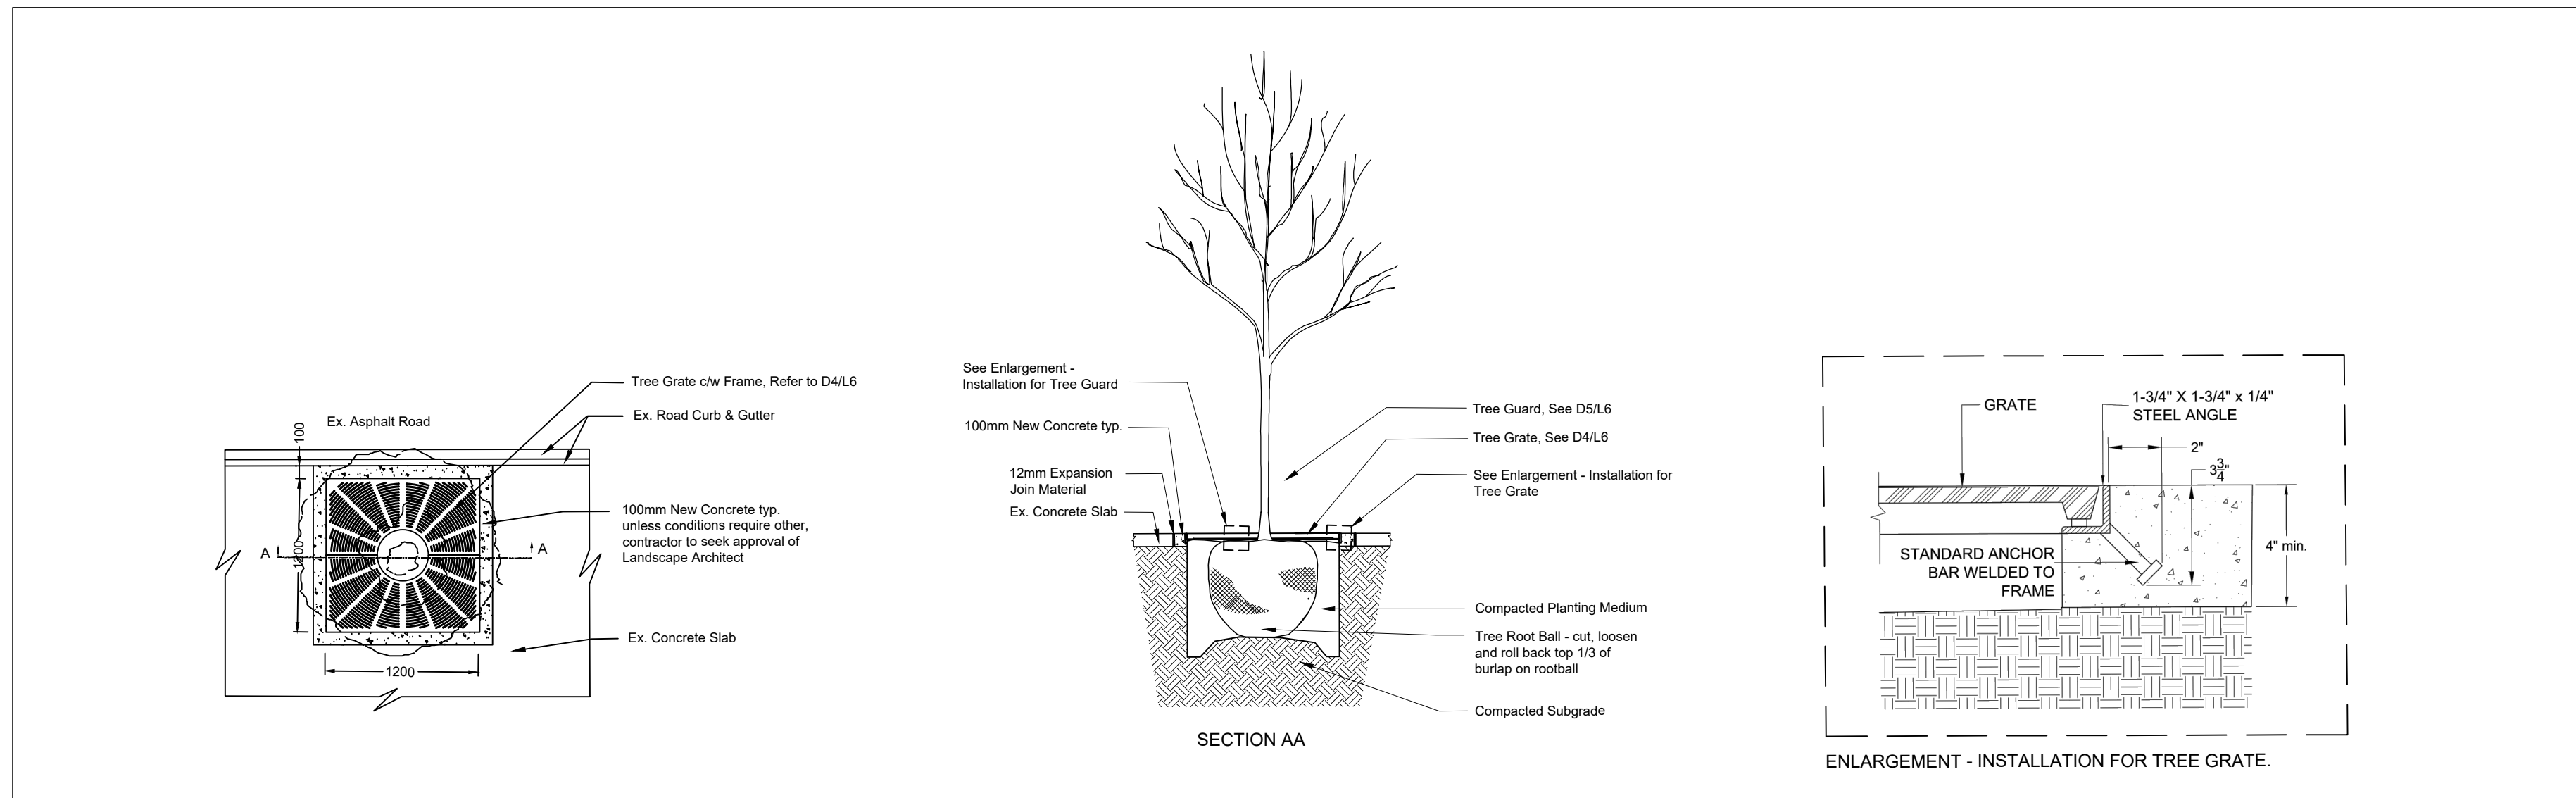


1 Tree Pit (New)
plan & section

NTS

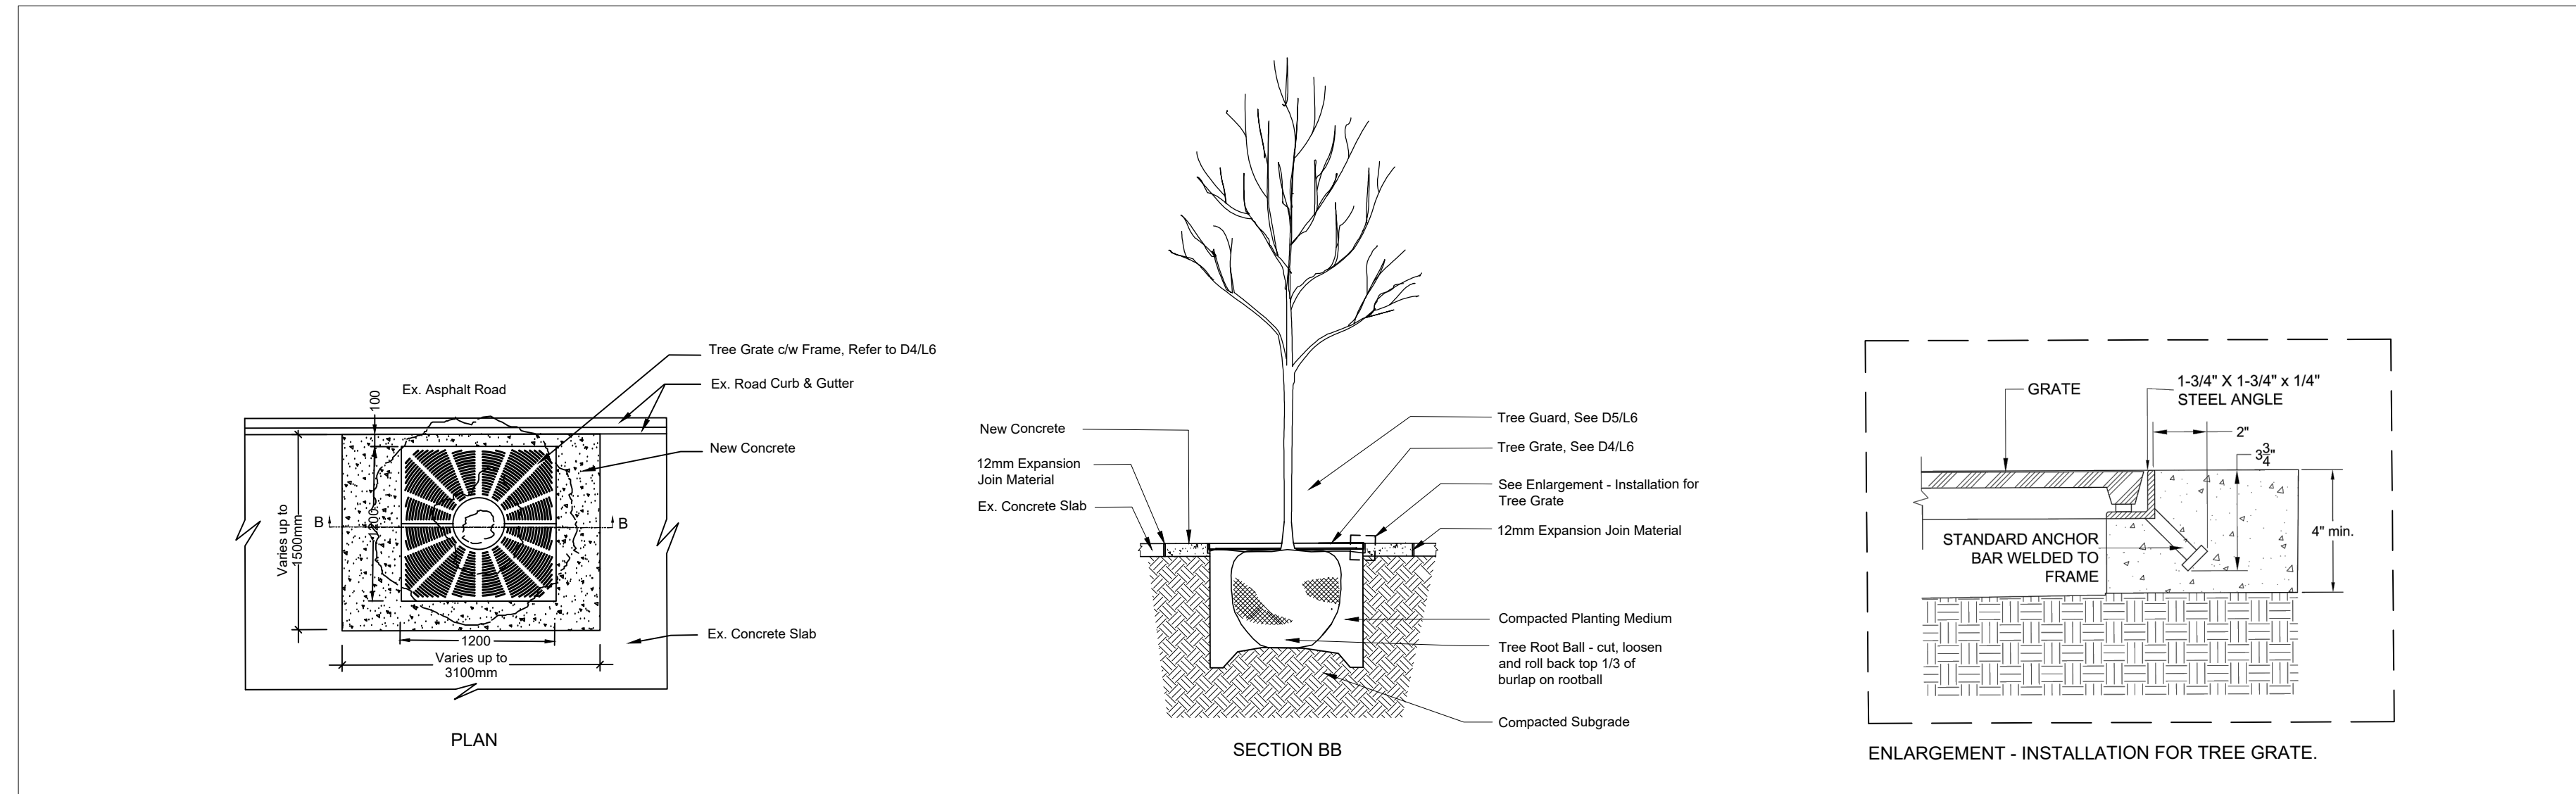

2 Tree Pit (Upgraded)
plan & section


NTS

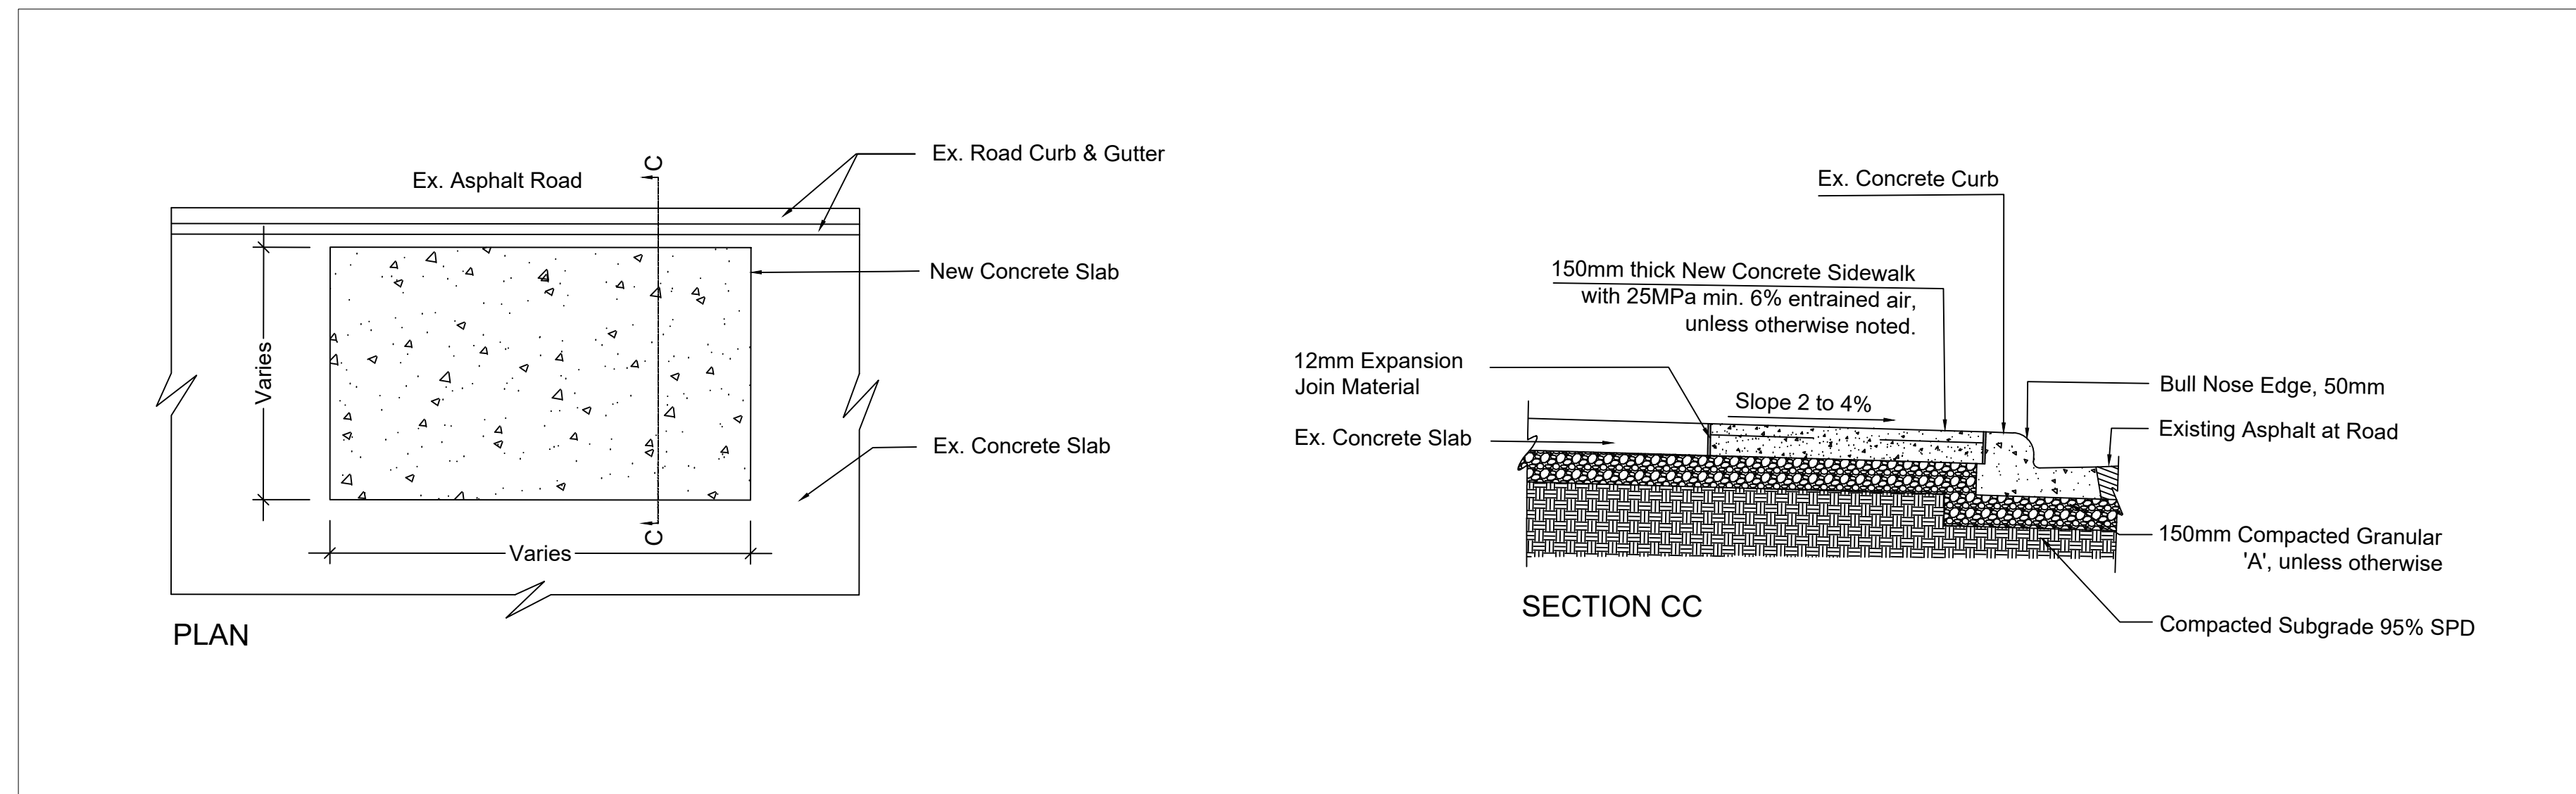

3 Tree Pit (Ex.) Concrete Filling
plan & section


NTS

4'x4' TREE GRATE #8954, PLAZA Set, BY EJ.

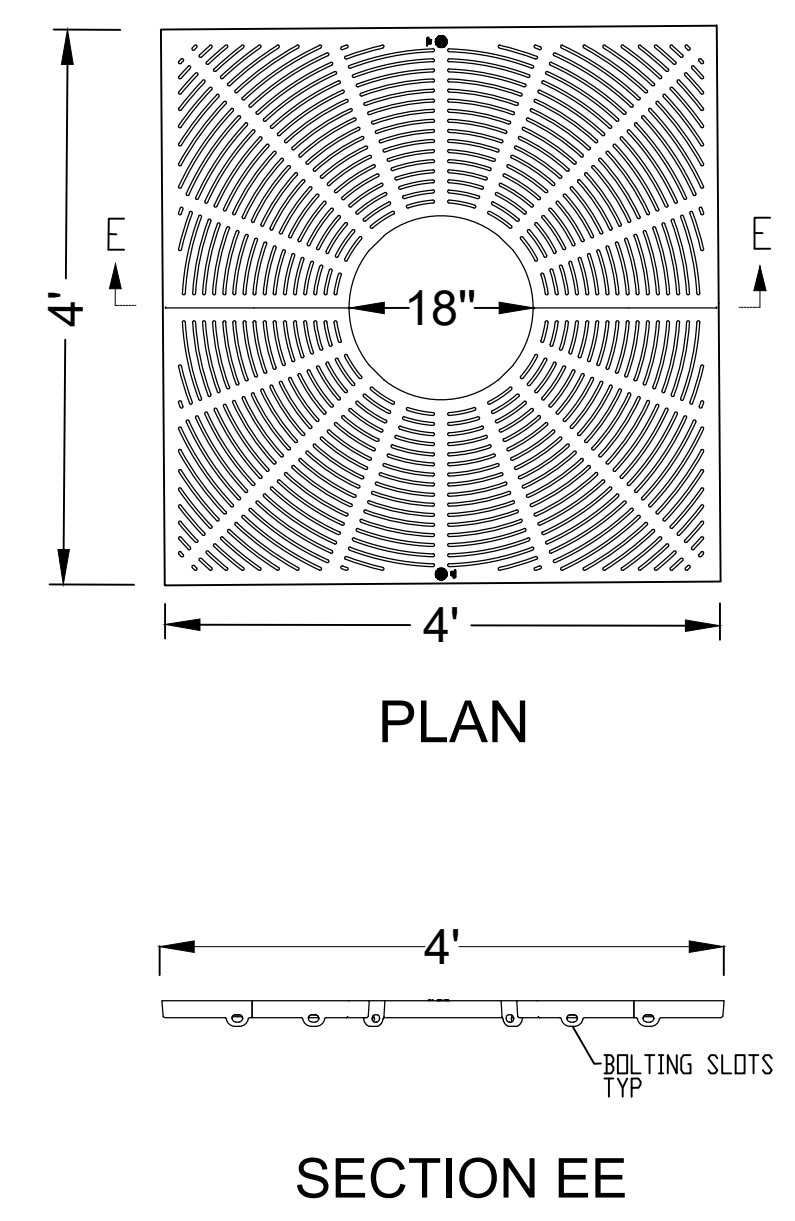

4 Removal of Existing Tree Pit (Concrete Fill)
Typ.

NTS

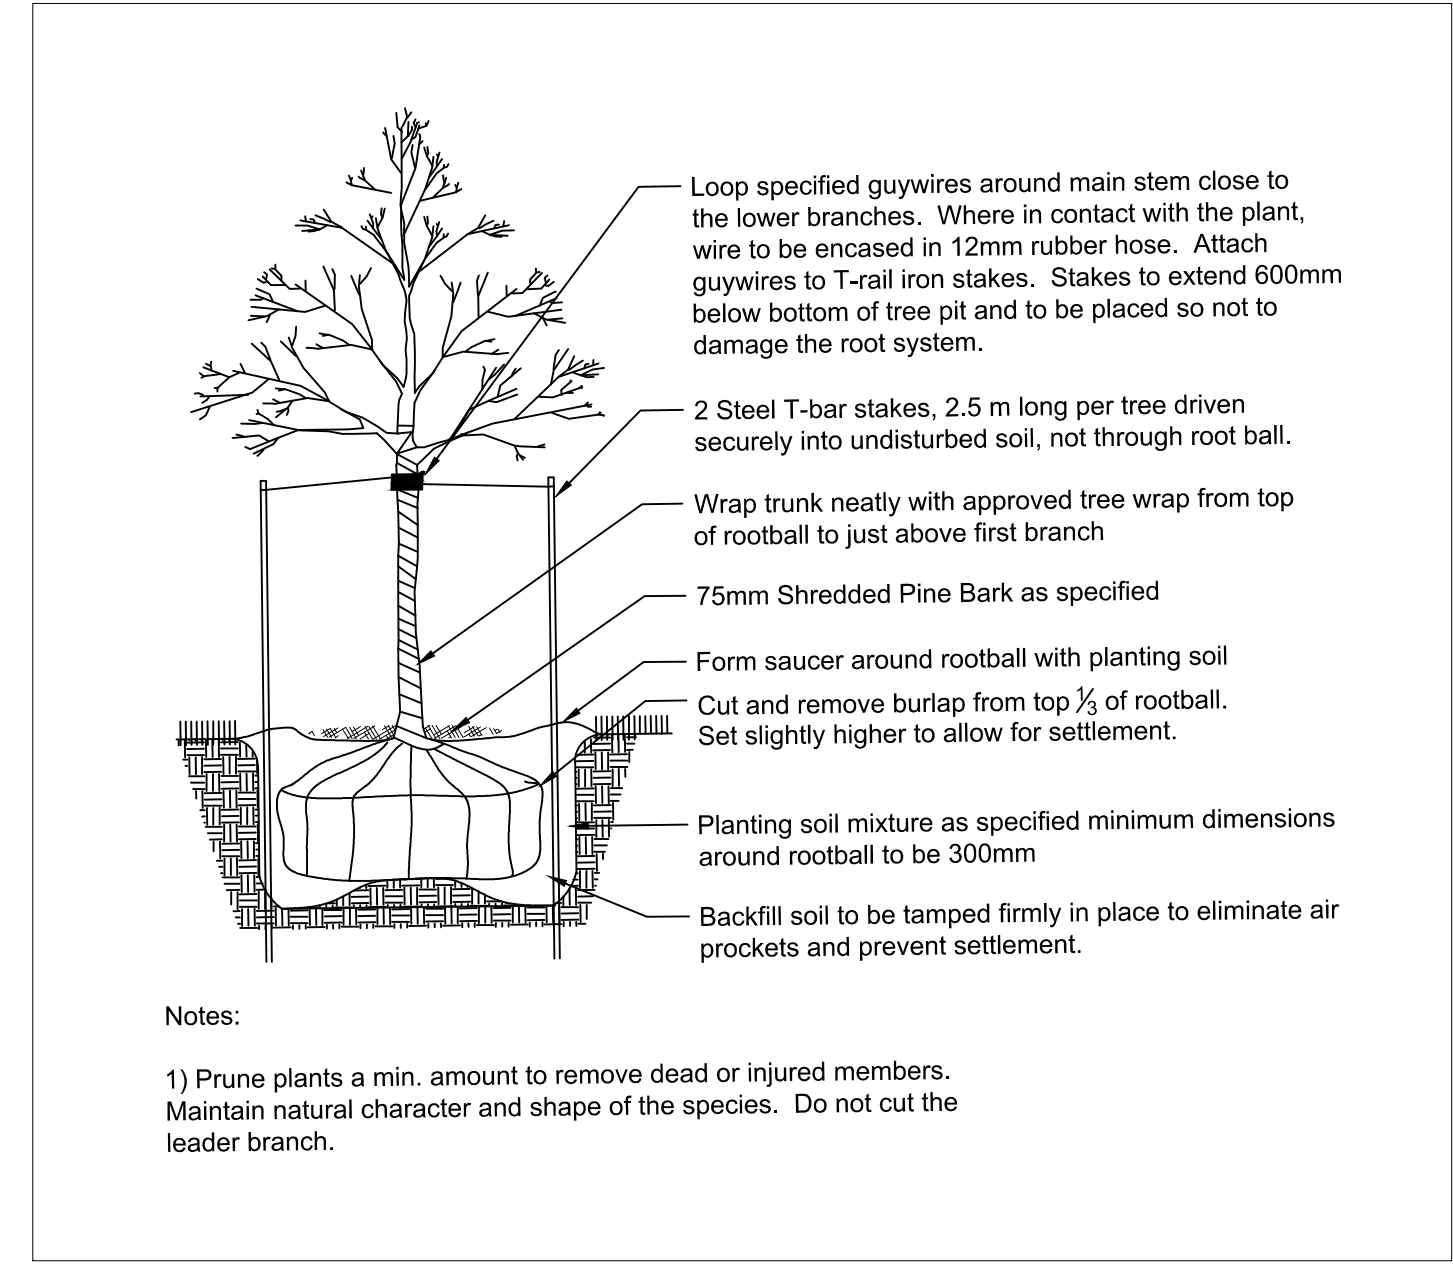

5 Deciduous Tree Planting
Typ.

NTS

- Notes
- The contractor shall line up tree grate halves for easy access.
 - The contractor shall install tree grates and seek approval of the Landscape Architect prior to proceeding with tree planting.
 - No tree pits/cavities to be left uncovered presenting hazard to the public. It is contractor's responsibility to ensure all hazards are adequately addressed.

As Constructed
Per Site Review 28 Feb 2024

- Notes
- The contractor shall check and verify all dimensions and conditions on the project and immediately report any discrepancies to the Landscape Architect before proceeding with work.
 - All dimensions are in millimeters unless otherwise stated.
 - The contractor shall layout the site and seek approval of the Landscape Architect prior to proceeding with work.
 - Project Boundary - Queen Street, Bridge Street, Lock Street East and Chestnut Street. Existing sidewalk, and concrete curbs to remain undisturbed unless otherwise noted.

No.	Date	Item
4	29 Feb. 2024	Revised - As Constructed Drawings
3	8 Mar. 2022	Revised - for County Review
2	10 Jan. 2022	For County Review
1	13 Dec. 2021	Review

This drawing is an instrument of professional services and is intended for the use only in connection with the project covered by the consultant agreement.



ska
Stempski Kelly Associates Inc.
Design Landscape Architecture Planning
P.O. Box 399, Fergus, ON. N1M 3E2
Voice (519) 787 4313
sean@ska-design.ca www.ska-design.ca

Project Title
Dunnville Downtown Street Tree Planting
Queen Street, Bridge Street, Lock Street East and Chestnut Street, Dunnville ON

JY/TV
Drawn
SK
Checked

Project No.
February 2024
Date

Sheet Title
DETAILS
Scale
As Shown
Sheet No.
L6